

Section 32 Township 13 Range 14W

Well No. #3 Boxberger "A"

Company Cities Service

Big Creek

NORTH

		o					

WEST

EAST

SOUTH

Sec. 32 Twp. 13 R. 14W

Well No. #3 Boxberger "A" Farm _____
Cities Service Company _____


Big Creek

990 Ft. from N. Line

_____ Ft. from S. Line

990 Ft. from E. Line

_____ Ft. from W. Line
SW NE NW

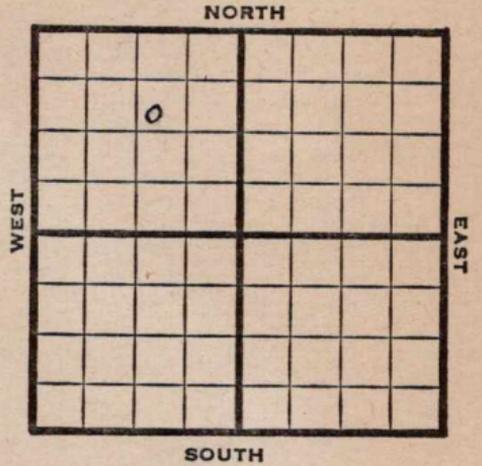

1947 Elev. 1872' REPORT

10/22 560' Drlg.

10/29 8" @ 652'
Drlg. 3232'

11/5 Lansing 3039'
Arbuckle 3307'
TD 3309'
Sat
5" @ 3307'
RUST

11/12 SIM 3309-06
Lansing 3036'
Arbuckle 3304'
5" @ 3304' TD 3304'
Pump 135 bbls. oil 8 hrs. / 3% W.

11/19 "

11/25 "

12/3 Arbuckle 3304'
5" @ 3304'
Pump 135 oil & 3% W Pot
Gr. 390
Total Depth 3307'

COMPLETED

Kansas

Big Creek

Map No. _____ Sec. 32 Twp. 13 R. 14W

Well No. 3 Boxberger "A"

Cities Service

Company

FIRST REPORT

Contractor

SW NE NW

SECTION PLAT

990 Ft. from N. Line

_____ Ft. from S. Line

990 Ft. from E. Line

_____ Ft. from W. Line

	o		

Russell County

Location _____

Rig up _____

Drilling and Remarks:

560'

RECORD

Cased _____ in., _____ ft.

Sand _____

Gas _____

Oil _____

Total Depth _____

PRODUCTION

1st 24 hrs. Nat. _____

1st 24 hrs. after shot _____

Gas _____ Cu. Ft.

Dry Hole _____

Abandoned _____

Date

OCT 22 1947

19

S. J. LEWIS

Scout

Map No. 72 Sec. 32 Twp. 13 R. 14W

Well No. 3 Boxberger "A"

Cities Service Company

COMPLETE

Contractor

SW NE NW

E 1/8 72

SECTION PLAT

990 Ft. from N. Line

_____ Ft. from S. Line

990 Ft. from E. Line

_____ Ft. from W. Line

	0		

Russell County

RECORD

Location _____

Cased _____ in., _____ ft.

Rig up _____

Sand _____

Drilling and Remarks:

Gas _____

Oil _____

Total Depth 3307

Cert 3804
5" @ 3804
Pump. 135 oil +
3 to NW 24

3934

PRODUCTION

1st 24 hrs. Nat. _____

1st 24 hrs. after shot _____

Gas _____ Cu. Ft.

Dry Hole _____

Abandoned _____

Date

DEC 3 1947 19

S. J. LEWIS

Scout