


Map No. 11 Sec. 23 Twp. 28 R. 3
 Well No. 2 Branch Farm _____
So. L. Oil Company _____

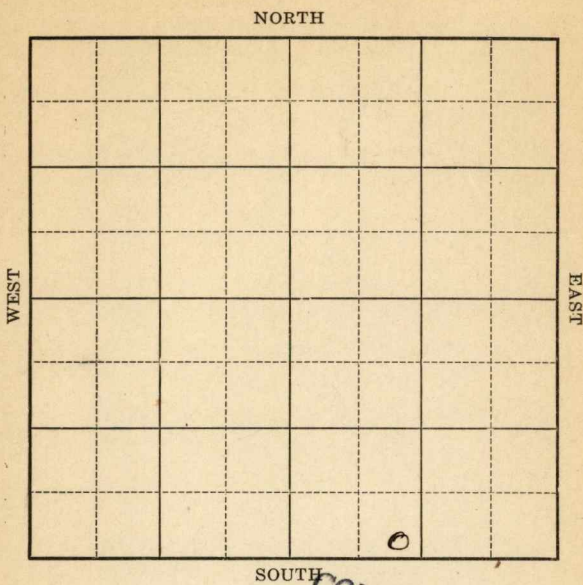

COMPLETED

Location _____

Drilling Remarks:

Rig Up _____

Drilling Remarks:

RECORD

Cased _____ in. _____ ft.

Sand _____

Gas _____

Oil _____

Total Depth _____

PRODUCTION

1st 24 hrs. Nat. _____

1st 24 hrs. after shot _____

Gas _____ cu. ft.

Dry Hole _____

Abandoned _____

Map No. _____ Sec. 23 Twp. 28 R. 5

Well No. 2 brany Farm _____
S. & S. de P Company _____


NORTH

_____ Ft. from N. Line

200 Ft. from S. Line

_____ Ft. from E. Line

1120 Ft. from W. Line

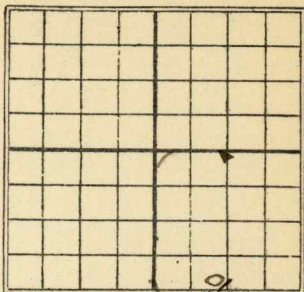

500' COMPLETED

Date 1/22

REPORT

1/3 Qty 2250
1/27 2765-2784 -
22 2787 -
Shot 10 qts / flooded
270 lbs

Map No. 11 Sec. 23 Twp. 28 R. 5
 Well No. 2 Craig Farm
St. L. Oil Company
 Date Started _____ Ft. from N. S200E W 1120 line

NORTH

Kansas

WEST

EAST

SOUTH

Cased _____ In. _____ Ft.

Sand _____

 Pay { Gas _____
 Oil _____

Total Depth _____

Production Remarks

Condition of Well on this date _____

L.O.g. at 2250'

M. A. BENEAR

Scout

Map No. *K11* Sec. *23* Twp. *28* R. *5*Well No. *2-Craig**St Oil* Company

Contractor

COMPLETED

SECTION PLAT

Ft. from N. Line

201' Ft. from S. Line*1120* Ft. from E. Line

Ft. from W. Line

Location

Rig up

Drilling and Remarks:

*sand { 2765
 2784
T.D. 2787'
shot 1095
flowing 270 Hb*

RECORD

Cased _____ in., _____ ft.

Sand _____

Gas _____

Oil _____

Total Depth _____

PRODUCTION

1st 24 hrs. Nat. _____

1st 24 hrs. after shot _____

Gas _____ Cu. Ft.

Dry Hole _____

Abandoned _____

Date

JAN 27 1922

M. A. BENEAR

191

Scout