

Map No. *N* Sec. *23* Twp. *28* R. *5*Well No. *2 Craig* Farm*Shawnee, Father, Shogun* Company

NORTH

WEST

EAST

SOUTH

Location -----

Drilling Remarks:

Rig Up -----

Drilling Remarks:

RECORD

Cased ----- in. ----- ft.

Sand -----

Gas -----

Oil -----

Total Depth -----

PRODUCTION

1st 24 hrs. Nat. -----

1st 24 hrs. after shot -----

Gas ----- cu. ft.

Dry Hole -----

Abandoned -----

COMPLETED

Map No. *K* Sec. *23* Twp. *28* R. *5*


Well No. *2 Craig* Farm
Shawon. Luthers Straugh Company
 NORTH

Ft. from N. Line

200 Ft. from S. Line

1120 Ft. from E. Line

Ft. from W. Line

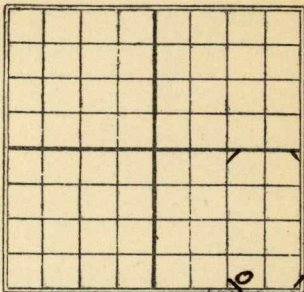

SOUTH
 COMPLETED

Date
1924

REPORT

1/3 *ully d 2370*
1/27 *2754-2784-*
shot 545 - flow
245 bbls.

Map No. 11 Sec. 23 Twp. 28 R. 5Well No. 2 Craig FarmShawver, Sutter & Strasmyer CompanyDate Started _____ Ft. from N. S 200 E 1/2 W lineNORTH Texas

WEST

FIRST REPORT

EAST

SOUTH

Cased _____ In. _____ Ft.

Sand _____

Pay { Gas _____
Oil _____

Total Depth _____

Production Remarks

Condition of Well on this date _____

NO. at 2370'

M. A. BENEAR

Scout

Map No. *K 11* Sec. *23* Twp. *28* R. *5*Well No. *2 - Orange**Shawner & Sutcliffe* Company

Contractor

COMPLETED

SECTION PLAT

Ft. from N. Line

200 Ft. from S. Line*1120* Ft. from E. Line

Ft. from W. Line

Location

Rig up

Drilling and Remarks:

sand { 2734'
{ 2784'
shot 59 lb
flow 245 ft

RECORD

Cased _____ in., _____ ft.

Sand _____

Gas _____

Oil _____

Total Depth _____

PRODUCTION

1st 24 hrs. Nat. _____

1st 24 hrs. after shot _____

Gas _____ Cu. Ft.

Dry Hole _____

Abandoned _____

Date

JAN 27 1922

191

M. A. BENEAR

Scout