


Section 32 Township 13 Range 1/W

Well No. 6 - Boxberger "A"

Company Cities Service Oil

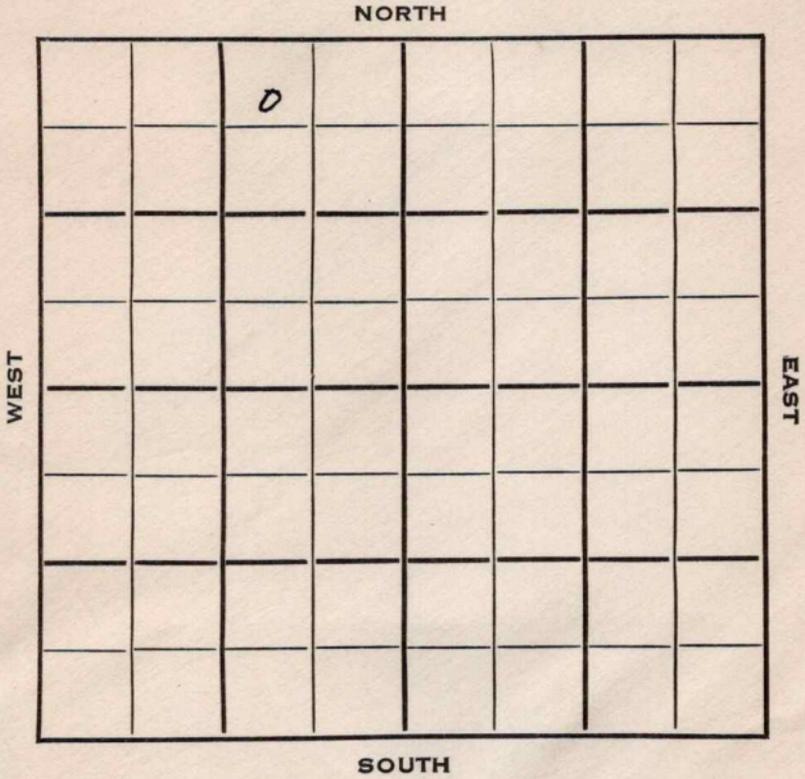

Russell

KANSAS ✓

Sec. 32 Twp. 13 R. 14W

Well No. #6 Boxberger "A" Farm

Cities Service Oil Company

Contractor


330 Ft. from N. Line

Ft. from S. Line

990 Ft. from E. Line

Ft. from W. Line

NW NE NW

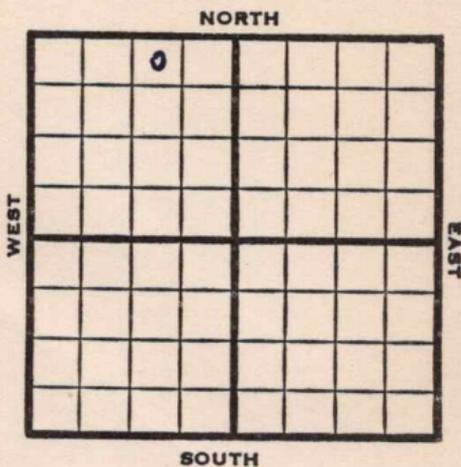

1952 Elev. 1874' REPORT

12/23 Location

12/25 Location

1/1 Drlg. 400

1/8 8" @ 608 Top 2764 Heeb 2988 Dodge 3006  
Lans 3039 Arb 3307 RTD 3311 5" @ 3308

1/14 Spud 12-23-52  
Oil Well TD 3321  
8" @ 608

Top. 2764, Heeb. 2988, Dodge  
3006, Lans 3039, Arb. 3307

TD 3311  
5" @ 3308 DD 3321  
Comp. 119 bopd 5 bw

**COMPLETED**

County **Russell** State **Kansas**

Sec. **32** (Blk. Twp.) **13** (Sur. Rge.) **14W** Map No.

Operator **Cities Service Oil**

Well No. **6** Farm **Boxberger "A"**

Elev. Location **NW NE NW**

		0			

**330** Ft. From **N** Line **NW**  
**990** Ft. From **E** Line Quarter

Ist. Report **DEC 23 1952**

Completion

Remarks

Spudding Date

Drlg. Data

**Location**

1281 05 030

J. G. McGEHEE

