


Section 1 Township 30 Range 7E

Well No. #1 Canon *(Cannon)*

Company H & M Drlg.

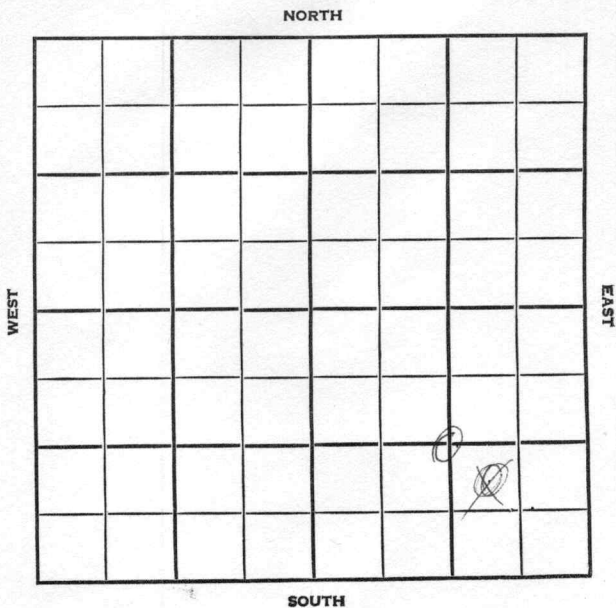

WILDCAT

FORM 513 SUNRAY

County Cowley Elev. _____
Sec. 1 Twp. 30 Rge. 7E
Company H. & M. Drlg.
Farm Name Canon No. 1

TOPS	DEPTH	LOG	DATUM	Loc. in Sec.
Anh.				NW SE SE
Tp.				
H.				
Tr.				
Dg.				
Bl.				
L.				Geol. _____
K.C.				Contr. _____
B.K.C.				
Ce.				
C.				
M.				
M.				Pool
K.				Wildcat
Mz.				
Mq.				
V.				
S.				
S.				
A.				
R.				
Pe.				
G.				
T.D.				

FIRST REPORT
NOV 21 56

Date Comm. _____
Location _____

30

Co.
Lse.
No.
Sec.
T.
R.

CORRECTION

FORM 513 SUNRAY

County Cowley Elev. 1466
 Sec. 1 Twp. 30 Rge. 7E
 Company H. & M. Drlg.
 Farm Name Canon No. 1

TOPS	DEPTH	LOG	DATUM
Anh.			
Tp.			
H.			
Tr.			
Dg.			
BL.			
L.			
K.C.	1982		
B.K.C.	2227		
Ce.			
C. <u>chkbd</u>	2320		
M. <u>osw.</u>	2410		
M. <u>CE</u>	2467		
K. <u>M. chat</u>	2757		
Mz. <u>" 61</u>	2781		
Me.			
V.			
S.			
S.			
A.			
R.			
PE.			
G.			
TD.	2820		

Loc. in Sec. NW SE SE
C-SE

Geol. _____

Contr. _____

Pool _____

Wildcat

ABANDONED
 DEC 20 1956

Date Comm. _____

Location NOV 29 '56 11-26-56 10" e.

80/75 ID 140 DEC 5 '56 ID 2470

DEC 12 '56 DEC 19 '56

D.E.A.

Co.

Lse.

No.

Sec.

T.

R.