


Section 1 Township 30 Range 7-E

Well No. #1 Dunne


Company Adair & Morton

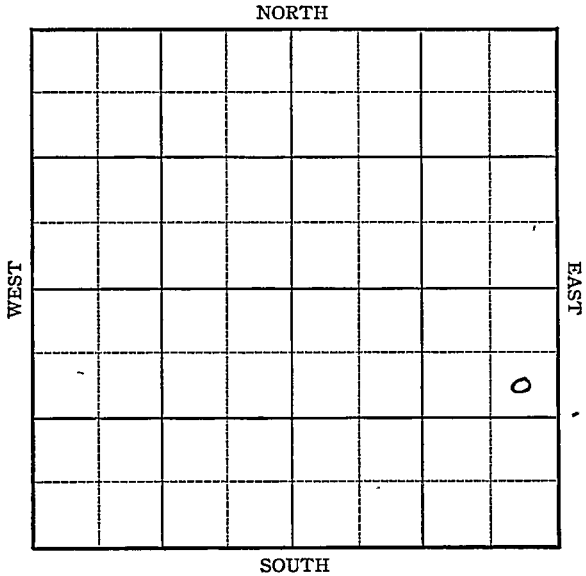

Sec. 1 Twp. 30 R. 7-E

Well No. #1 Dunne Farm
Adair & Morton Company

NORTH

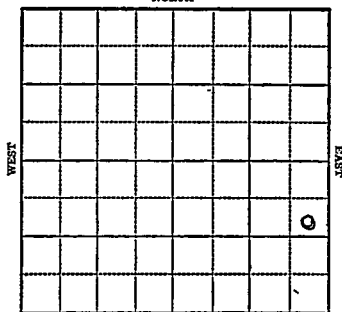

990 Ft. from N. Line

_____ Ft. from S. Line

330 Ft. from E. Line

_____ Ft. from W. Line

Miscellaneous

1943 *Elev. 1487* REPORT

7/28 Location
8/4 " "
8/11 " "
8/18 " "
8/25 15" @ 20'
Drlg. 600'
9/1 Drlg. 1150
9/8 12" @ 1230'
10" @ 1690'
Drlg. 1900'
9/15 KC 1955
T.D. 2150
Run 8"
9/22 Miss 2753
Water
T.D. 2822

ABANDONED

Map No. 10 Sec. 1 Twp. 30 R. 7E

Well No. 1 Dunne

Adair & Morton Company

FIRST REPORT Contractor

SE NE SE

SECTION PLAT

990 Ft. from N. Line

_____ Ft. from S. Line

330 Ft. from E. Line

_____ Ft. from W. Line

			o

MISCELLANEOUS

Location XXXX

Rig up _____

Drilling and Remarks:

RECORD

Cased _____ in., _____ ft.

Sand _____

Gas _____

Oil _____

Total Depth _____

PRODUCTION

1st 24 hrs. Nat. _____

1st 24 hrs. after shot _____

Gas _____ Cu. Ft.

Dry Hole _____

Abandoned _____

Date _____

JUL 28 1943 19

S. J. LEWIS Scout

KANSAS

Map No. 10 Sec. 1 Twp. 30 R. 7E

Well No. 1 Dunne

Adair & Morton Company

ABANDONED Contractor

SE NE SE

SECTION PLAT

990 Ft. from N. Line

_____ Ft. from S. Line

330 Ft. from E. Line

_____ Ft. from W. Line

Miscellaneous

Location _____

Rig up _____

Drilling and Remarks:

Miss 2753

Water

RECORD

Cased _____ in., _____ ft.

Sand _____

Gas _____

Oil _____

Total Depth 2822

PRODUCTION

1st 24 hrs. Nat. _____

1st 24 hrs. after shot _____

Gas _____ Cu. Ft.

Dry Hole _____

Abandoned _____

Date

SEP 22 1943 19

S. J. LEWIS Scout