

KANSAS

Map No. _____ Sec. 3 Twp. 14 R. 17-W

Well No. 2-Goetz Farm _____

Twin Drilling Company


_____ Ft. from N. Line

990 Ft. from S. Line

_____ Ft. from E. Line

990 Ft. from W. Line

Elev. 1998

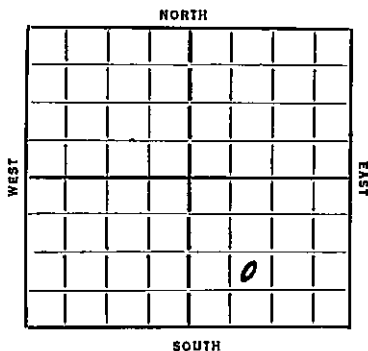

Date
1936

REPORT

- 4/8 Location
- 4/16 Rig.
- 4/23 Rigging up.
- 4/30 15" @ 390'. Drlg. 802'.
- 5/7 Drlg. 1520'.
- 5/14 Drlg. 2475'.
- 5/21 Drlg. 2950'. 8" @ 2760'.
- 5/28 Oswald 3264'. 7" @ 3307'. H.F.W.
at 3348'. To 53'. U.R. 7".
- 6/4 Conglomerate 3509'. 3514' fishing.
- 6/11 Sil. 3512'. S.O. 3525-34'. 1500'
from 3541-44'. T.D. 3560'.
- 7/1/36-Sil. 3512'.
1500 gallons of acid.
T.D. 3560'.
4,000 gallons of acid.
Pump 412 bbls of oil.

COMPLETED ~~ABANDONED~~ COMPLETED

Map No. 71 Sec. 13 Twp. 14 R. 17NWell No. 2 GoetzTwin Milling Company

Contractor

SECTION PLAT

.....Ft. from N. Line

990 Ft. from S. Line

.....Ft. from E. Line

990 Ft. from W. Line

FIRST REPORT

Location

Rig up.....

Drilling and Remarks:

RECORD

Cased.....in.,ft.

Sand.....

Gas.....

Oil.....

Total Depth.....

PRODUCTION

1st 24 hrs. Nat.....

1st 24 hrs. after shot.....

Gas.....Cu. Ft.

Dry Hole.....

Abandoned.....

Date

4/8/26 192.....

S. J. LEWIS Scout

