


Kansas

Map No. _____ Sec. 23 Twp. 28 R. 15
Well No. 1 Craig Farm _____
St. J. Company _____

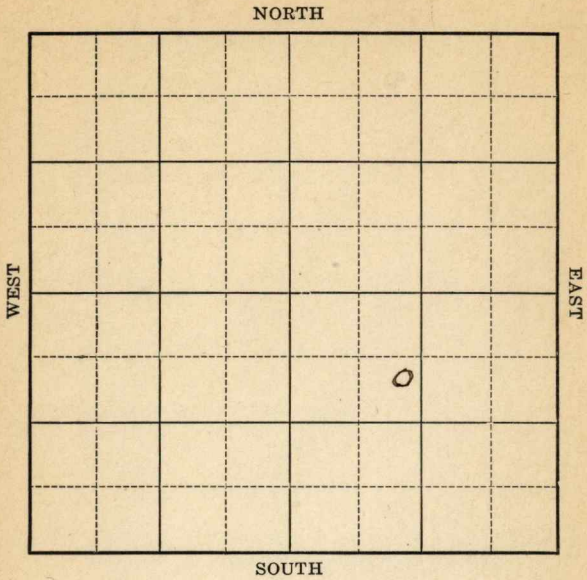

Location _____
Drilling Remarks: _____

RECORD

Cased _____ in. _____ ft.
Sand _____
Gas _____
Oil _____
Total Depth _____

Rig Up _____
Drilling Remarks: _____

PRODUCTION

1st 24 hrs. Nat. _____
1st 24 hrs. after shot _____
Gas _____ cu. ft.
Dry Hole _____
Abandoned _____

Map No. _____ Sec. 23 Twp. 28 R. 5


Well No. #7 Craig Farm _____
8115 Company _____

810 Ft. from N. Line

_____ Ft. from S. Line

_____ Ft. from E. Line

1120 Ft. from W. Line

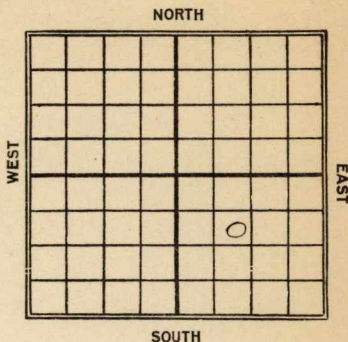

Date	REPORT
1922	
7/22	Rog
1923	
6/23	Rig 4 location
	Abandoned.

Map No. Kans 11 23 Sec. 28 Twp. 5 R. 5

Well No. 7 Craig

S + S. Company

Contractor

FIRST REPORT


SECTION PLAT

810' Ft. from N. Line

_____ Ft. from S. Line

_____ Ft. from E. Line

1120 Ft. from W. Line

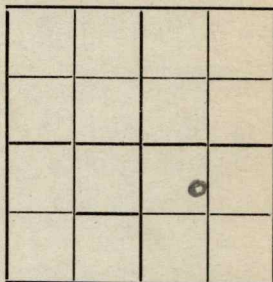

Location _____

Rig up _____

Drilling and Remarks:

R.O.S.

RECORD

Cased _____ in., _____ ft.

Sand _____

Gas _____

Oil _____

Total Depth _____

PRODUCTION

1st 24 hrs. Nat. _____

1st 24 hrs. after shot _____

Gas _____ Cu. Ft.

Dry Hole _____

Abandoned _____

Date

JUL 22 1922

M. A. BENEAR

191

Scout

Map No. **KANSAS** 11 23 Sec. 23 Twp. 28 5 R. 5

Well No. 7 Craig

S. S. Company

Contractor

ABANDONED SECTION PLAT

810 Ft. from N. Line

Ft. from S. Line

Ft. from E. Line

1120 Ft. from W. Line

		0	

Location

Rig up

Drilling and Remarks:

Rigs Loc
Abandoned**RECORD**

Cased _____ in., _____ ft.

Sand _____

Gas _____

Oil _____

Total Depth _____

PRODUCTION

1st 24 hrs. Nat. _____

1st 24 hrs. after shot _____

Gas _____ Cu. Ft.

Dry Hole _____

Abandoned _____

Date

JUN 23 1923

M. A. BENEAR

192

Scout