

Ellis


KANSAS

FORM 51 5M 2-38 TPCO.

Section 3 Township 14 Range 17-N

Well No. 3 Goetz

Company Twin Drilling

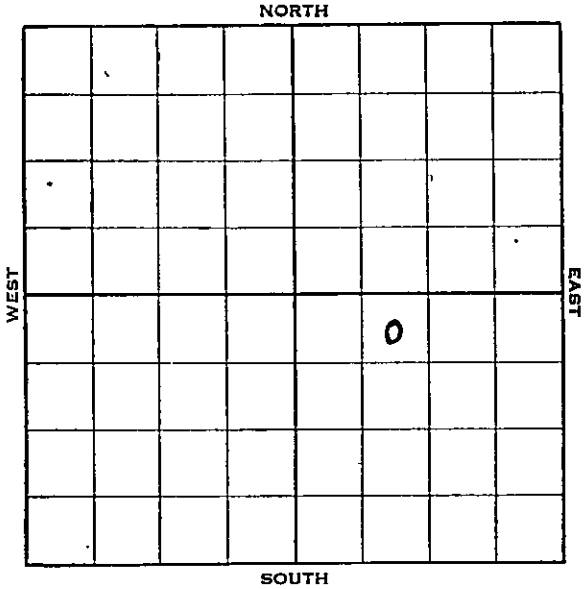

Sec. 3 Twp. 14 R. 17-W

Well No. #3 Goetz Farm

Twin Drilling Company


440 Ft. from N. Line

_____ Ft. from S. Line

_____ Ft. from E. Line

990 Ft. from W. Line

Elev. 1993

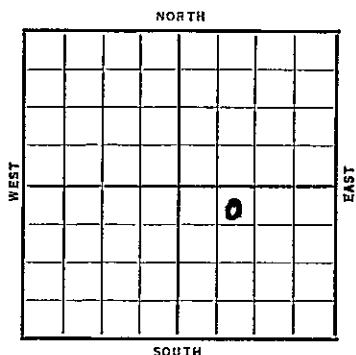

Date	REPORT
1938	
7/20	10" - 100'.
	Anhy. 1177'.
	Drlg. 1187'.
7/29	Drlg. 2325'.
8/5	Drlg. 3070'.
8/12	Arb. 3504'. T.D. 3507'.
	5" - 3504'. Dlg. cement.
8/19	T. D. 3351'. 850' oil 2½ hrs.
	3000 acid. Swab 30 oil per hour.
8/24	5" at 3504'.
	Arb. 3504'.
	T. D. 3531'.
	7000 acid.
	Pump 262 bbls. 4 hrs. & 320 bbls.
	4 hours.
	Potential 1573 bbls.
	COMPLETED

Map No. 71 Sec. 3 Twp. 14 R. 17WWell No. 3 GoetzTwin Drilling Company

Contractor

FIRST REPORT

NE NW SE

440 Ft. from N. Line

_____ Ft. from S. Line

_____ Ft. from E. Line

990 Ft. from W. Line

SECTION PLAT

		o	.

Location _____

Rig up _____

Drilling and Remarks:

10" - 100Anhy. 1177Drlg. 1187

RECORD

Cased _____ in., _____ ft.

Sand _____

Gas _____

Oil _____

Total Depth _____

PRODUCTION

1st 24 hrs. Nat. _____

1st 24 hrs. after shot _____

Gas _____ Cu. Ft.

Dry Hole _____

Abandoned _____

Date

JUL 20 1938 19 _____ H. D. Hatfield Scout

Ellis

Map No. 71 Sec. 3 Twp. 14 R. 17WWell No. 3 Goetz

Twin Drlg.

Company

Contractor

COMPLETED

NE NW SE

440 Ft. from N. Line

_____ Ft. from S. Line

_____ Ft. from E. Line

990 Ft. from W. Line

SECTION PLAT

		0	

Location _____

Rig up _____

Drilling and Remarks:

7000 acidP-26 2/4 x 320/4POT 1573

RECORD

Cased 5 in., 3504 ft.Sand Arb 3504

Gas _____

Oil _____

Total Depth 3531

PRODUCTION

1st 24 hrs. Nat. _____

1st 24 hrs. after shot _____

Gas _____ Cu. Ft.

Dry Hole _____

Abandoned _____

Date

AUG 24 1938

19

H. D. Hatfield

Scout