

Kansas


Map No. _____ Sec. 23 Twp. 28 R. 5

Well No. 5 Craig Farm

S. 9. S.

Company

NORTH

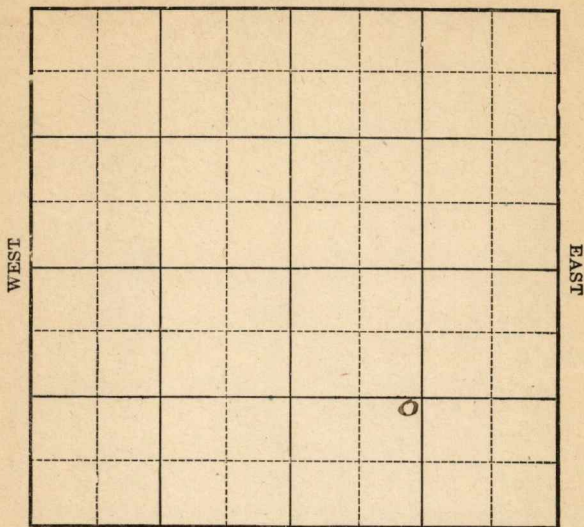

SOUTH

Location _____

Drilling Remarks:

Rig Up

Drilling Remarks:

RECORD

Cased _____ in. _____ ft.

Sand _____

Gas _____

Oil_____

Total Depth_____

PRODUCTION

1st 24 hrs. Nat._____

1st 24 hrs. after shot_____

Gas _____ cu. ft.

Dry Hole _____

Abandoned _____

Map No. K11 Sec. 23 Twp. 28 R. 5Well No. 3 CraigCompany J. S.

Contractor _____

FIRST REPORT

SECTION PLAT

_____ Ft. from N. Line

1120 Ft. from S. Line

_____ Ft. from E. Line

1120 Ft. from W. Line

Location _____

Rig up _____

Drilling and Remarks:

tools & Rig,

RECORD

Cased _____ in., _____ ft.

Sand _____

Gas _____

Oil _____

Total Depth _____

PRODUCTION

1st 24 hrs. Nat. _____

1st 24 hrs. after shot _____

Gas _____ Cu. Ft.

Dry Hole _____

Abandoned _____

Date

MAR 12 1922

191

M. A. BENEAR

Scout

11 Kane
 Map No. _____ Sec. 23 Twp. 28 R. 5

Well No. 5 Craig

_____ Company

_____ Contractor

COMPLETED

SECTION PLAT

		0	

_____ Ft. from N. Line

_____ Ft. from S. Line

_____ Ft. from E. Line

_____ Ft. from W. Line

Location _____

Rig up _____

Drilling and Remarks:

shot 40 g b

RECORD

Cased _____ in., _____ ft.

Sand _____

Gas _____

Oil 2765-2815

Total Depth 2815

PRODUCTION

1st 24 hrs. Nat. _____

1st 24 hrs. after shot 300

Gas _____ Cu. Ft.

Dry Hole _____

Abandoned _____

Date

MAY 21 1922

M. A. BENEAR

191

Scout