


Cowley

KANSAS

Section 16 Township 30 Range 7E

Well No. #1 ~~Whiteman~~ Lee

Company K.T. Weidemann

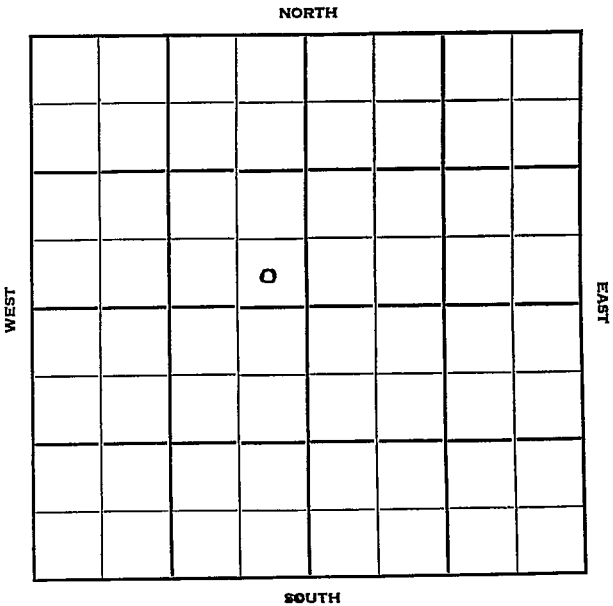

Cowley

KANSAS

Sec. 16 Twp. 30 R. 7 E ✓

Well No. # 1 ^{Lee} ~~Whiteman~~ Farm

K. T. Weidemann Company

Contractor


330 Ft. from N. Line

330 Ft. from S. Line

990
330 Ft. from E. Line

_____ Ft. from W. Line

NW NE SW
SE SE NW

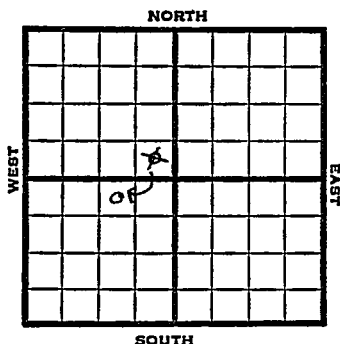

1951

Elev. 1478' REPORT


5/16

Location

8/1

Spud 6-3-51
Oil Well TD 2917
KC 2125 Miss 2889
7" @ 2890
TD 2917 500 A
Comp. 15 bopd

COMPLETED

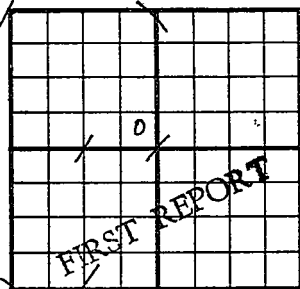County Cowley State KansasSec. 16 (Blk. 30 (Sur. 7E Map No.Operator K. T. WeidemannWell No. 1 Farm WhitemanElev. Location SE SE NW330 Ft. From S Line NW330 Ft. From E Line Quarter1st. Report MAY 16 1951

Completion

Remarks

Spudding Date

Drlg. Data

Location

J. E. TYRA

Map No. _____ Sec. 16 Twp. 30 R. 7EWell No. 1 Lee

_____ K. T. Weidemann _____ Company

CORRECTION

_____ Contractor

NW NE SW

SECTION PLAT

330 Ft. from N. Line

_____ Ft. from S. Line

990 Ft. from E. Line

_____ Ft. from W. Line

	0		

Cowley County

RECORD

Location _____

Rig up _____

Drilling and Remarks:

Cased _____ in., _____ ft.

Sand _____

Gas _____

Oil _____

Total Depth _____

Reported _____

#1 Whitman _____

SE SE NW

PRODUCTION

1st 24 hrs. Nat. _____

1st 24 hrs. after shot _____

Gas _____ Cu. Ft.

Dry Hole _____


Abandoned _____

Date

MAY 29 1951 19

J. E. TYRA

Scout

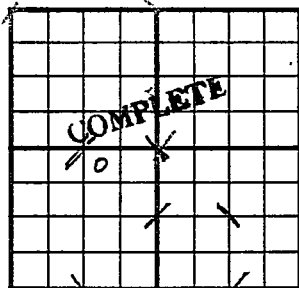County Cowley State KansasSec. 16 (^{Blk.}_{Twp.}) 30 (^{Sur.}_{Rge.}) 7E Map No. _____Operator K. T. WeidemannWell No. 1 Farm LeeElev. 1478 Location NW NE SW330 Ft. From N Line SW990 Ft. From E Line Quarter

1st. Report _____

Completion AUG 1 1951

Remarks _____

Spudding Date 6-3-51Drlg. Data Oil well TD 2917KC 2125 Miss. 2889 7" @ 2890 TD 2917500 A Comp. 15 bopd

J. E. TYRA