


Section 23 Township 28 Range 5 E

Well No. # 1 Crowley

Company E. B. Shawver

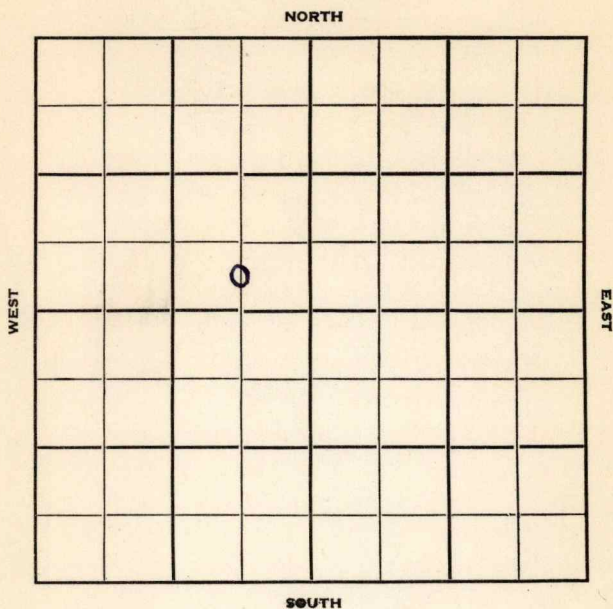

Butler

KANSAS

Sec. 23 Twp. 28 R. 5 E

Well No. # 1 Crowley Farm

E. B. Shawver Company

Shawver Contractor

Fox-Bush Pool


 Ft. from N. Line

330 Ft. from S. Line

660 Ft. from E. Line

 Ft. from W. Line

C SL SE NW

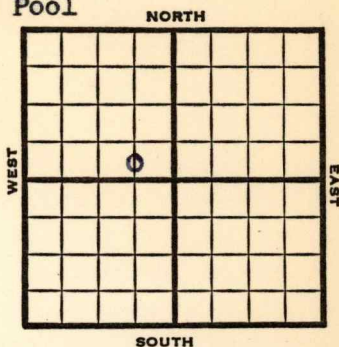

1951

Elev. 1339'

REPORT

12/12

Spud 12-11-51
Spudding

1952
1/9

Spud 12-11-51
D&A TD 2925
8" @ 44

Miss. 2828

DST 2828-63 open 45 min. rec. 240'

SGCM TD 2925


D&A


ABANDONED

County **Butler** State **Kansas**Sec. **23** (Blk.) **28** (Sur.) **5E** Map No.Operator **E. B. Shawver**Well No. **1** Farm **Crowley**Elev. Location **C S L SE NW****330** Ft. From **S** Line **NW****660** Ft. From **E** Line Quarter1st. Report **DEC 1 2 1951**

Completion

Remarks

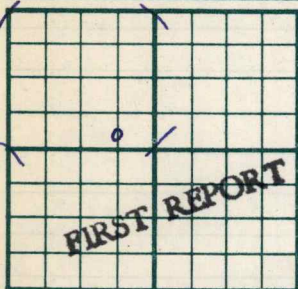Shawver - Contr.Spudding Date **12-11-51**Drlg. Data **Fox - Bush Pool****Spdg.****J. E. TYRA**

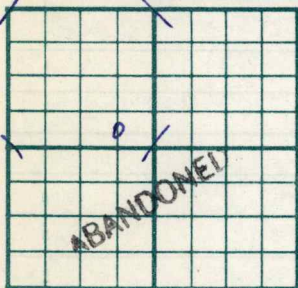County Butler State KansasSec. 23 (Blk. Twp.) 28 (Sur. Rge.) 5 E Map No.Operator E. B. ShawverWell No. 1 Farm CrowleyElev. 1339 Location C S L SE NW330 Ft. From S Line NW660 Ft. From E Line Quarter1st. ReportCompletion JAN 9 1952Remarks Fox-Bush PoolShawver - Contr.Spudding Date 12-11-51Drlg. Data D & A TD 29258" @ 44 Miss. 2828 DST 2828-63open 45 min. Rec. 240' sgcm TD 2925D & A

W.C.

J. E. TYRA