

KANSAS


Section 20 Township 30 Range 7E

Well No. 3 Stolp

Company K.T. Weidemann

Misc.

NORTH

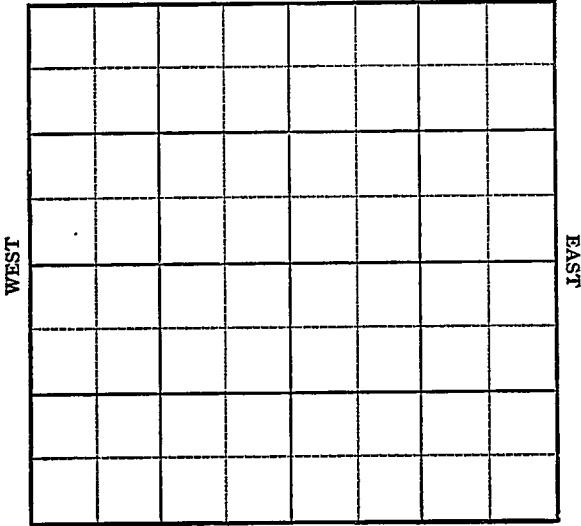

SOUTH

KANSAS

Cowley

Sec. 20 Twp. 30 R. 7E

Well No. #3 Stolp Farm  
K. T. Weidemann Company

Miscellaneous


\_\_\_\_\_ Ft. from N. Line

330' Ft. from S. Line

990' Ft. from E. Line

\_\_\_\_\_ Ft. from W. Line

SW SE SE

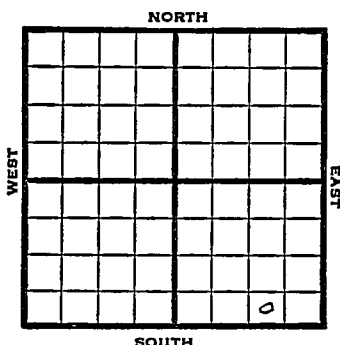

1948

Eli 1479'

REPORT

10/27

8" @ 89'  
Drlg. 1409'

11/3

Drlg 2810'

11/10

Miss 2875'  
TD 2881'  
5" @ 2881'

11/16

TD 2909

11/23

SO  
SD

11/30

"

12/6

"

12/15

TD 2909'  
Miss 2875'  
5" @ 2881'  
1000 acid  
Pump 15 Oil Pot  
38° Gr.  
Comp

**COMPLETED**

Map No. \_\_\_\_\_ Sec. 20 Twp. 30 R. 7E

Well No. 3 Stolp

K. T. Weidemann Company

FIRST REPORT Contractor

SW SE SE

SECTION PLAT

\_\_\_\_\_ Ft. from N. Line

330 Ft. from S. Line

990 Ft. from E. Line

\_\_\_\_\_ Ft. from W. Line


Cowley County

Location \_\_\_\_\_

Rig up \_\_\_\_\_

Drilling and Remarks:

8" @ 89

drlg. 1409

RECORD

Cased \_\_\_\_\_ in., \_\_\_\_\_ ft.

Sand \_\_\_\_\_

Gas \_\_\_\_\_

Oil \_\_\_\_\_

Total Depth \_\_\_\_\_

PRODUCTION

1st 24 hrs. Nat. \_\_\_\_\_

1st 24 hrs. after shot \_\_\_\_\_

Gas \_\_\_\_\_ Cu. Ft.

Dry Hole \_\_\_\_\_

Abandoned \_\_\_\_\_

Date

OCT 27 1948 19

S. J. LEWIS Scout

