

Sec. 21 Twp. 30 R. 7E ✓

Well No. #3 Beightel Farm

K. T. Weidemann Company

Contractor


990 Ft. from N. Line

990 Ft. from S. Line

_____ Ft. from E. Line

330 Ft. from W. Line

~~SW NW~~
~~NW SW SW~~

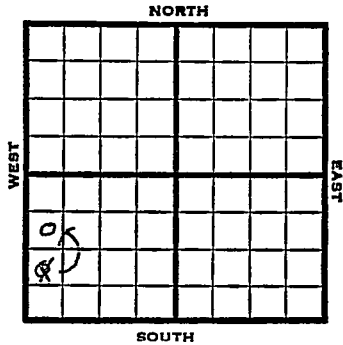

1950 Elev 1476' REPORT

12/13 Cellar & Pits

1951

1/24

KC 2133-2366 Miss 2880-85
5" @ 2885
TD 2908 $\frac{1}{2}$ 1000 A
Comp 35 bopd 100 BW
Completed TD 2908 $\frac{1}{2}$

COMPLETED

Map No. _____ Sec. 21 Twp. 30 R. 7EWell No. 3 BeightolK. T. Weidemann CompanyCORRECTION Contractor

SW NW SW

SECTION PLAT

990 Ft. from N. Line

_____ Ft. from S. Line

_____ Ft. from E. Line

330 Ft. from W. Line

o			

Cowley County

Location _____

Rig up _____

Drilling and Remarks:

Reported

NW SW SW

RECORD

Cased _____ in., _____ ft.

Sand _____

Gas _____

Oil _____

Total Depth _____

PRODUCTION

1st 24 hrs. Nat. _____

1st 24 hrs. after shot _____

Gas _____ Cu. Ft.

Dry Hole _____

Abandoned _____

Date

DEC 27 1950 19J. E. TYRA

Scout

