


Kansas

Map No. _____ Sec. 23 Twp. 28 R. 5

Well No. 4 Crawley Farm _____
Crum Etal Company _____

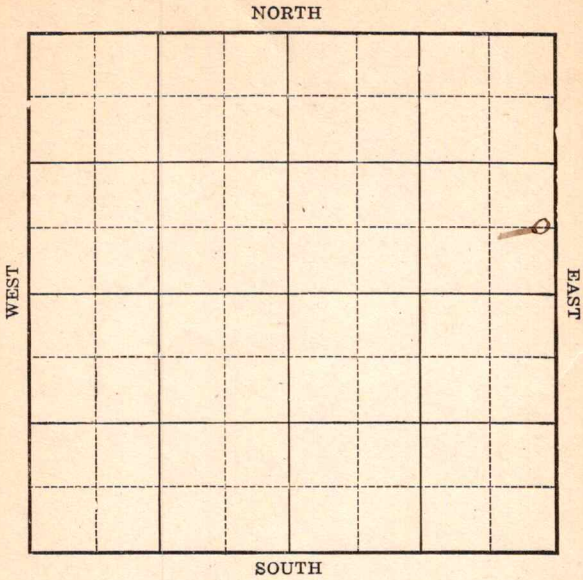

Location _____

Drilling Remarks:

RECORD

Cased _____ in. _____ ft.

Sand _____

Gas _____

Oil _____

Total Depth _____

Rig Up _____

Drilling Remarks:

PRODUCTION

1st 24 hrs. Nat. _____

1st 24 hrs. after shot _____

Gas _____ cu. ft.

Dry Hole _____


Abandoned _____

Map No. _____ Sec. 23 Twp. 28 R. 5Well No. #4 Crowley Farm
Crum et al Company

_____ Ft. from N. Line

660 Ft. from S. Line200 Ft. from E. Line

_____ Ft. from W. Line

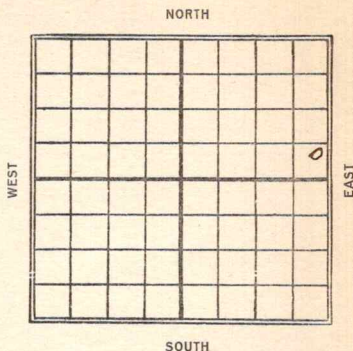

Date

REPORT

19223/20R. O. G.3/30Dlg 1595'5/212762-84 Shot 15 gto
100 bbls

Kansas

Map No. K11 Sec. 23 Twp. 28 R. 3Well No. 4 CrumpseyCrumpsey Company

Contractor

FIRST REPORT

SECTION PLAT

Ft. from N. Line

400 Ft. from S. Line200 Ft. from E. Line

Ft. from W. Line

			o

Location

Rig up

Drilling and Remarks:

R.O. G.

RECORD

Cased _____ in., _____ ft.

Sand _____

Gas _____

Oil _____

Total Depth _____

PRODUCTION

1st 24 hrs. Nat. _____

1st 24 hrs. after shot _____

Gas _____ Cu. Ft.

Dry Hole _____

Abandoned _____

Date

MAR 20 1922

191

M. A. BENEAR

Scout

Map No. Kans Sec. 23 Twp. 28 R. 5

Well No. 4 Crawley
Crum et al. Company

Contractor

COMPLETED

SECTION PLAT

_____ Ft. from N. Line

660 Ft. from S. Line

200 Ft. from E. Line

_____ Ft. from W. Line

			0

COMPLETED

RECORD

Location _____

Cased _____ in., _____ ft.

Rig up _____

Sand _____

Drilling and Remarks:

Gas _____

Oil 2762-84'

Total Depth 2784

PRODUCTION

1st 24 hrs. Nat. _____

1st 24 hrs. after shot 100

Gas _____ Cu. Ft.

Dry Hole _____

Abandoned _____

Date

MAY 21 1922

M. A. BENEAR

191

Scout