


Cowley

KANSAS

SECTION 20 TOWNSHIP 30S RANGE 7E

WELL NO. #1 Whitman

COMPANY Augusta Oil

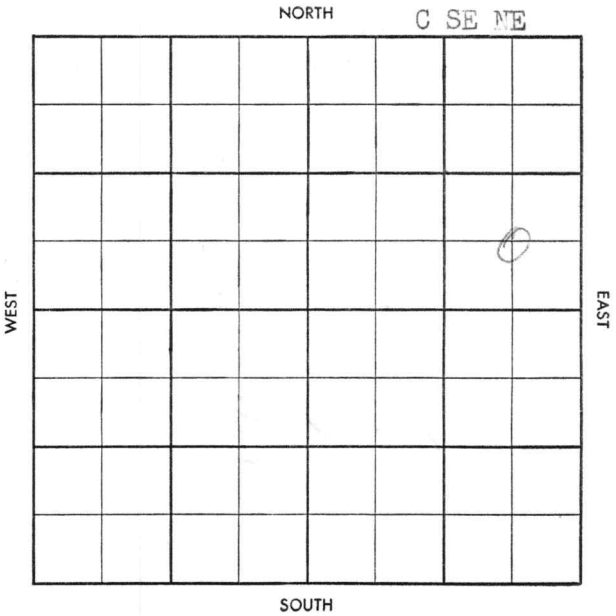

BO

CO. Cowley ELEV. \_\_\_\_\_

SEC. 20 TWP. 30 RGE. 7E

COMPANY Augusta Oil NO. 1



FARM Whitman

LOC. C SE NE


GEOL. \_\_\_\_\_

CONTR. Co. tools

POOL Box

SPUD \_\_\_\_\_

M I R

CO.  
LSE.  
NO.  
SEC.  
TWP.  
RGE.

CO. Cowley ELEV. 1477 DA  
SEC. 20 TWP. 30 RGE. 7E  
COMPANY Augusta Oil NO. 1

JAN 2 '58

ABANDONED

FARM Whitman

LOC. C SE NE

KC 2132
M 2900
TD 2935

GEOL. \_\_\_\_\_  
CONTR. Co. tools  
POOL Box  
SPUD 12-19-57  
MIR DEC 26 '57 5'  
100 SD 2000  
JAN 2 '58  
no log

DA

CO.

LSE.

NO.

SEC.

TWP.

RGE.