

Ellis

KANSAS

3

14


17W

SECTION \_\_\_\_\_ TOWNSHIP \_\_\_\_\_ RANGE \_\_\_\_\_

WELL NO. #2 Goetz "C"

COMPANY Okmar

NORTH E/2 E/2 SW

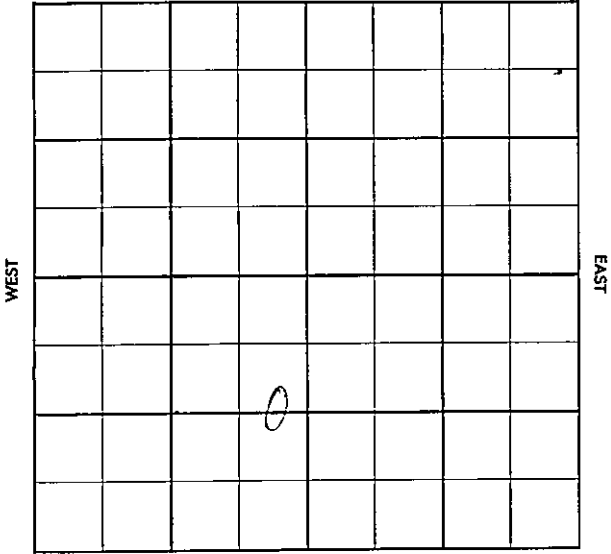

SOUTH

County Edlis Elev. \_\_\_\_\_  
 Sec. 3 Twp. 14 Rgs. 17W  
 Company Okmar  
 Farm Name Goetz "C" No. 2

TOPS	DEPTH	LOG	DATUM
Anh.			
Tp.			
H.			
Tr.			
Dg.			
Bl.			
L.			
K.C.			
B.K.C.			
Ce.			
C.			
M.			
M.			
K.			
Mz.			
Mo.			
V.			
S.			
S.			
A.			
R.			
Pe.			
G.			
T.D.			

Loc. in Sec. E/2E/2 SW

Geol. \_\_\_\_\_  
 Contr. Leben Tools

Pool \_\_\_\_\_

FIRST REPORT

FEB 20 '57

Date Comm. 2-16-57  
8 5/8" 213/150 DrLg. 1850

14

Co.

Loc.

No.

Sec.

T.

R.

Co.

Loc.

No.

Sec.

T.

R.

1

County Elvis Elev. 2000  
 Sec. 3 Twp. 14 Rge. 17W  
 Company Okmar  
 FarmName Goetz "C" No. 2

TOPS	DEPTH	LOG	DATUM	Loc. in Sec.
Anb.	1185			E/2E/2 SW
TP.				
H.	3223			
Tr.	3244			
Dg.				
Bl.				
L.				Geol.
N.C.	3271			
B.M.C.				Contr.
Ce.				Leben Tools
C.				
M.				Pool
M.				
K.				
Mz.				
Mo.				
V.				
S.				
S.				COMPLETE MAR 27 57
A.	3513			
R.				
PE.				
G.				
TD.	3531			

Date Comm. 2-16-57

8 5/8" 213/150 Drlg. 1850

DST 2293-3300 1hr rec 85'

MSW FPO BHP 890/30"

DST 3306-20 1hr rec 915'

OC SW BHP 1000/30" DST

3334-42 1hr rec 15' 50"

SPKd SW BHP 120 3360

MAR 27 57 DST 3513-19 1hr 12' Md

BHP 490/20 DST 3519-25

1hr 14' 0cm BHP 290/30  
 DST 3525-31 1hr 15' 50cm  
 BHP 500/30 5 1/2 @ 3515 HAN '3 '57  
 MICT CO 3531 1000A SF  
 \$ 20FH 50% wtr pop HAN '3 '57  
 P. 15 Bopd + 15 Bwpd.