

Section 1 Township 15 Range 15^W

Well No. #1 De Wald

Company Sterns Pet.

NORTH

6							

WEST

EAST

SOUTH

Russell KANSAS

Sec. 1 Twp. 15 R. 15 W

Well No. # 1 De Wald Farm

Stearns Pet. Company

Contractor

Gorham


330 Ft. from N. Line

Ft. from S. Line

Ft. from E. Line

330 Ft. from W. Line

NW NW NW

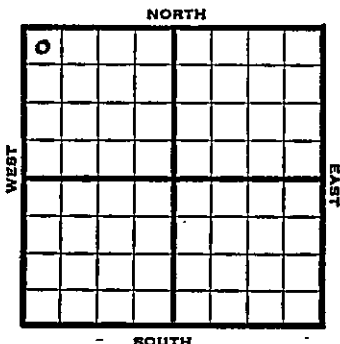

1952

Elev. 1789' REPORT

1/9

Spud 1-3-52
8" @ 197'
Anhy 817'
Drlg. 1774'

1/30

Spud 13-52
D&A TD 3312
8" @ 197 Anhy 817 Tarkio 2460
Heeb. 2942 Lans. 3001 Top. 2770
Cong. 3230 ReArb. 3239 Arb. 3258
TD 3312 D&A

ABANDONED

County **Russell** State **Kansas**Sec. **1** (Blk. **15** (Sur. **15W** (Twp. **15W** Map No.Operator **Sterns Pet.**Well No. **1** Farm **De Wald**Elev. Location **NW NW NW**

o									

330 Ft. From **N** Line **NW****330** Ft. From **W** Line **Quarter**Ist. Report **JAN 9 1952**

Completion

Remarks


Spudding Date **1-3-52**Drlg. Data **Gorham****8" @ 197 Anhy 817 Drlg. 1774****J. E. TYRA**

County Russell State Kansas
 Sec. 1 (Blk. Twp.) 15 (Sur. Rge.) 15W Map No.

Operator Sterns Drlg.

Well No. 1 Farm DeWald

Elev. 1789 Location NW NW NW

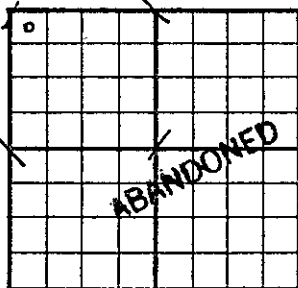

330 Ft. From N Line NW

330 Ft. From W Line Quarter

1st. Report

Completion JAN 30 1952

Remarks Gorham Pool

Spudding Date 1-3-52

Drlg. Data D & A TD 3312

8" @ 197 Anhy 817 Tarkio 2460

Heeb. 2942 Lans. 3001 Top. 2770

Cong. 3230 ReArb. 3239 Arb. 3258

TD 3312 D & A

J. G. McGEHEE