

Russell

KANSAS

FORM 51 5M 4-41 PETROL

Section 1 Township 15 Range 15WWell No. 1 DewaldCompany Eldorado Refining

			0				

NORTH

WEST

EAST


SOUTH

Sec. 1 Twp. 15 R. 15-WWell No. #1 DeWald FarmEldorado Refg. Company

(Big Creek)

330 Ft. from N. Line Ft. from S. Line330 Ft. from E. Line Ft. from W. Line

Elev. 1776

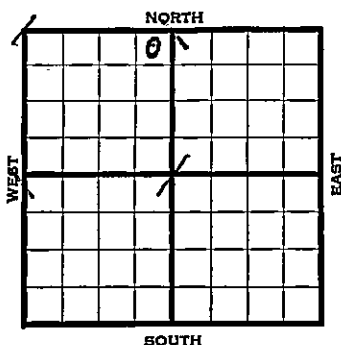

1941

REPORT

7/16 Bldg. Cable rig.

7/24 " " "

7/31 Rigging up

8/7 " " "

8/15 20" @ 20'

15" @ 280

13" @ 450

Drlg. 457'

8/21 Anhy 795' 10" - 805'

Drlg. 1445'

8/28 Drlg. 2136'

9/4 8" - 2423' Drlg. 2440'

9/11 8" - 2612' Drlg. 2705'

9/18 Dodge 2930' Lans. 2971'

Oil 3010-15' T.D. 240' oil fill

up, no time given. Run 7".

9/25 7" - 3015' T.D. 3045'

430' oil, fill up. Run tubing.

To acidize.

OVER

1941

10/1

Lans. 2971'

7" - 3015'

T.D. 3045'

3000 acid.

Potential 206 bbls., pump.

38. Gravity

COMPLETED

Map No. 73 Sec. 1 Twp. 15 R. 15WWell No. 1 DeWaldEldorado Refining Company

Contractor


FIRST REPORT

NE NW

330 Ft. from N. Line Ft. from S. Line330 Ft. from E. Line Ft. from W. Line

BIG CREEK POOL

SECTION PLAT

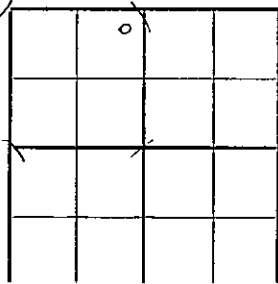Location Rig up Drilling and Remarks: Bldg. Cable Rig

RECORD

Cased in., ft.Sand Gas Oil Total Depth

PRODUCTION

1st 24 hrs. Nat. 1st 24 hrs. after shot Gas Cu. Ft.Dry Hole Abandoned

Date

JUL 16 1941 19S. J. LEWIS Scout

Russell

KANSAS

Map No. K-73 Sec. 1 Twp. 15 R. 15WWell No. 1 DeWaldEldorado Refining CompanyCOMPLETED Contractor

NE NW

330 Ft. from N. Line Ft. from S. Line330 Ft. from E. Line Ft. from W. Line

SECTION PLAT

		6	

BIG CREEK POOL

Location Rig up

Drilling and Remarks:

*have 2971
7" casing
3000 acid
Pump 206 Port*

38-2-92

RECORD

Cased in., ft.Sand Gas Oil Total Depth 3045

PRODUCTION

1st 24 hrs. Nat. 1st 24 hrs. after shot Gas Cu. Ft.Dry Hole Abandoned

Date

OCT 1 1941 19S. J. LEWIS Scout