
FORM 51 10M 7-48 PETROL O.W.W.O. KANSAS Russell

Section 1 Township 15 Range 15W

Well No. 1 Schwein

Company Carlock

Big Creek Pool

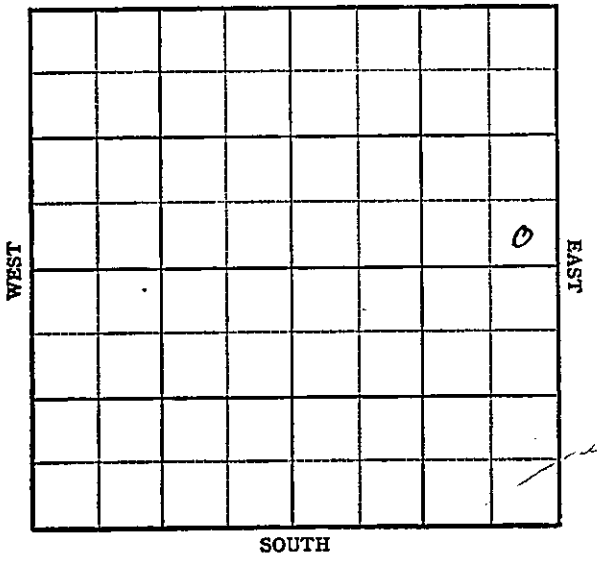

FORM 252-A
5M 10-48 PETROL

KANSAS Russell

Sec. 1 Twp. 15 R. 15W ✓

Well No. 1 Schwein Farm

Carlock Company

Big Creek Pool

O.W.W.O.


_____ Ft. from N. Line

330 Ft. from S. Line

330 Ft. from E. Line

_____ Ft. from W. Line

SE NE

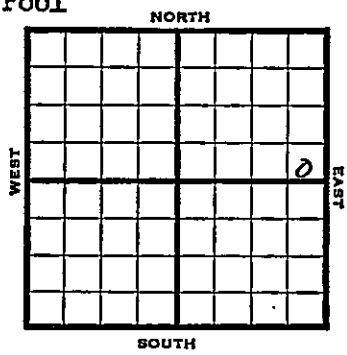

1948	REPORT
	Eli 1744'
11/17	R U R
11/23	"
11/30	8"@ 782'
	Drlg 1115'
12/8	Tarkio 2397'
	Topeka 2660'
	Lansing 2943'
	Drlg 3014'
12/15	TD 3185'
	Arb. 3180'
	Aband
	ABANDONED
1950	O.W.W.O.
5/31	Lans. 2943'
	So. 296 -69
	DST 3963-71 Rec. 30' of mud & oil
	Arb. 3180-85 TD
	D&A
	5½" @ 3021' WOC
6/7	Lans. 2940' Arb. 3180'
	5½" @ 3021'
	CO to 3100'
	Perf 21/2963-71
	Filled up 345' fluid 50% oil
	TD 3185'
	D&A
	ABANDONED

Form 26 200 Bks. 9-48 Petrol

Kansas

Big Creek Pool

Map No. _____ Sec. 1 Twp. 15 R. 15W


Well No. 1 Schwein

Carlock Company

FIRST REPORT Contractor

SE NE

SECTION PLAT

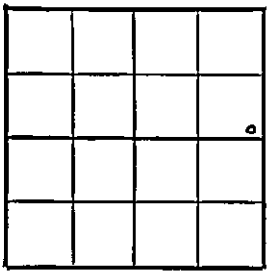

_____ Ft. from N. Line

330 Ft. from S. Line

330 Ft. from E. Line

_____ Ft. from W. Line

Russell County

Location

Rig up

Drilling and Remarks:

R U R

RECORD

Cased _____ in., _____ ft.

Sand

Gas

Oil

Total Depth

PRODUCTION

1st 24 hrs. Nat.

1st 24 hrs. after shot

Gas _____ Cu. Ft.

Dry Hole

Abandoned

Date

NOV 17 1948 19

S. J. LEWIS Scout

Form 26 200 Bks. 9-48 Petrol
Kansas

Big Creek Pool

Map No. 73 Sec. 1 Twp. 15 R. 15W

Well No. 1 Schwein


Carlock Company

ABANDONED Contractor

SE NE

E 1/2 44

SECTION PLAT

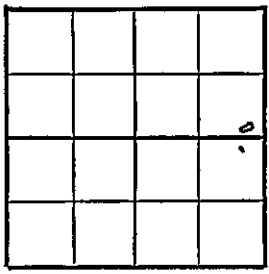

____ Ft. from N. Line

330 Ft. from S. Line

330 Ft. from E. Line

____ Ft. from W. Line

Russell County

Location

Rig up

Drilling and Remarks:

Ctx 3180

RECORD

Cased ____ in., ____ ft.

Sand

Gas

Oil

Total Depth 3180

PRODUCTION

1st 24 hrs. Nat.

1st 24 hrs. after shot

Gas ____ Cu. Ft.

Dry Hole

Abandoned

Date

DEC 15 1948 19

S. J. LEWIS Scout

Form 26 200 Blks. 11-49 Petrol

Kansas Big Creek

O.W.W.O.

Map No. _____ Sec. 1 Twp. 15 R. 15W

Well No. 1 Schwein

C. L. Carlock Company

Contractor

SE SE NE

El. 1744

SECTION PLAT



_____ Ft. from N. Line

330 Ft. from S. Line

330 Ft. from E. Line

_____ Ft. from W. Line

Russell OWWO

Location _____

Rig up _____

Drilling and Remarks:

Lans. 2943
So. 2966-69
DST 2963-71 Rec.
30' of Mud & oil,
Arb. 3180-85-TD
D & A

5½ @ 3021 WOC

RECORD

Cased _____ in., _____ ft.

Sand _____

Gas _____

Oil _____

Total Depth _____

PRODUCTION

1st 24 hrs. Nat. _____

1st 24 hrs. after shot _____

Gas _____ Cu. Ft.

Dry Hole _____

Abandoned _____

Date

MAY 31 1950 19

J. E. TYRA Scout

Form 26 200 Bks. 11-49 Petrol

Big Creek

Kansas

Map No. _____ Sec. 1 Twp. 15 R. 15W

Well No. 1 Schwein


C. L. Carlock Company

Contractor

SE SE NE

El. 1744

SECTION PLAT

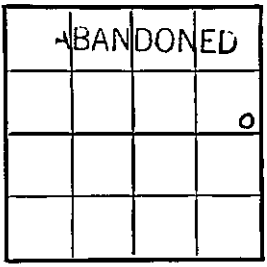

_____ Ft. from N. Line

330 Ft. from S. Line

330 Ft. from E. Line

_____ Ft. from W. Line

Russell

Location

Rig up

Drilling and Remarks:

Lans 2940
Arb 3180
5½" @ 3021
Clean out to 3100
perf 21/2963-71
filled up 345 fluid
50% oil D&A

RECORD

Cased _____ in., _____ ft.

Sand

Gas

Oil

Total Depth 3185

PRODUCTION

1st 24 hrs. Nat.

1st 24 hrs. after shot

Gas _____ Cu. Ft.

Dry Hole

Abandoned

Date

JUN 7 1950 19

J. E. TYRA Scout