


Kansas

Map No. _____ Sec. *23* Twp. *28* R. *5*

Well No. *5 Crawley* Farm _____

Crum Etal Company _____

NORTH

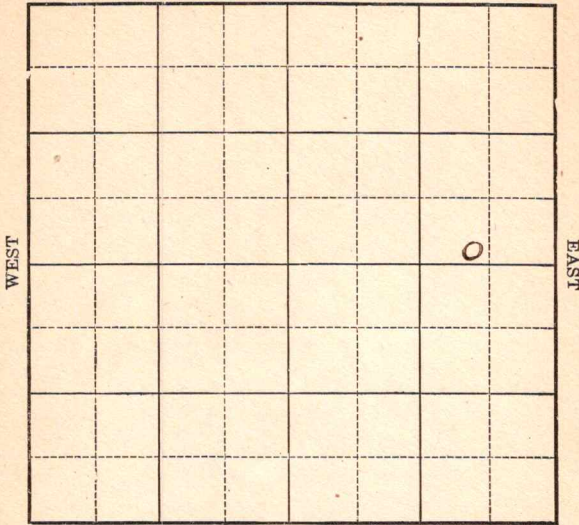

SOUTH

Location _____

Rig Up _____

Drilling Remarks:

Drilling Remarks:

RECORD

PRODUCTION

Cased _____ in. _____ ft.

1st 24 hrs. Nat. _____

Sand _____

1st 24 hrs. after shot _____

Gas _____

Gas _____ cu. ft.

Oil _____

Dry Hole _____

Total Depth _____

Abandoned _____

Map No. _____ Sec. 23 Twp. 28 R. 5


Well No. #5 Crawley Farm
Crum et al Company

_____ Ft. from N. Line

200 Ft. from S. Line

760 Ft. from E. Line

_____ Ft. from W. Line

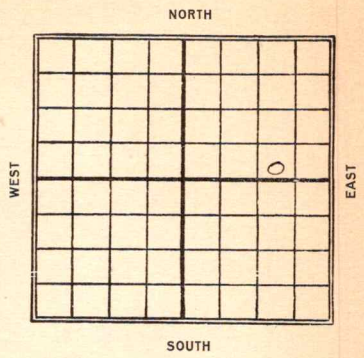

Date
1922

REPORT

5/21 Rig

7/22 2723-2723 TD

Shot 40 qts 250 lbs

Map No. 11 Camp Sec. 23 Twp. 28 R. 5

Well No. 3 Crawley

Crummett Company

Contractor

FIRST REPORT

SECTION PLAT

----- Ft. from N. Line

200 Ft. from S. Line

760 Ft. from E. Line

----- Ft. from W. Line

Location -----

Rig up -----

Drilling and Remarks:

Rig

RECORD

Cased ----- in., ----- ft.

Sand -----

Gas -----

Oil -----

Total Depth -----

PRODUCTION

1st 24 hrs. Nat. -----

1st 24 hrs. after shot -----

Gas ----- Cu. Ft.

Dry Hole -----

Abandoned -----

Date

MAY 21 1922

M. A. BENEAR

191

Scout

Map No. Range 23 Sec. 23 Twp. 27 R. 5

Well No. 3 Crowley
Crum et al. Compa

Contracto

COMPLETED

SECTION PLAT

----- Ft. from N. Line

200'

----- Ft. from S. Line

760'

----- Ft. from E. Line

----- Ft. from W. Line

Location -----

Rig up -----

Drilling and Remarks:

Shot Hoop

RECORD

Cased ----- in., ----- f

Sand -----

Gas -----

Oil 2723-2773

Total Depth 2773

PRODUCTION

1st 24 hrs. Nat. -----

1st 24 hrs. after shot 250

Gas ----- Cu. F

Dry Hole -----

Abandoned -----

Date

JUL 22 1922

M. A. BENEAR