Russell KANSAS

SECTION 1 TOWNSHIP 15 RANGE 15W

WELL NO. #1 Schwein

COMPANY J.L. King, etal

NORTH C N½ N½ NE

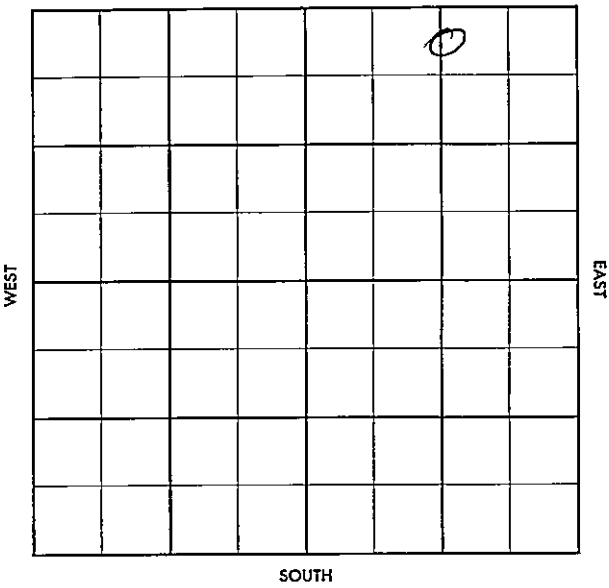

FORM 504-3 SUNRAY

FORM 513 SUNRAY

County Russell Elev.

Sec. 1 Twp. 15 Rge. 15W

Company J. E. King etal.

Farm Name Schwein No. 1

TOPS	DEPTH	LOG	DATUM
Anh.	793		
Tp.			
H.			
Tr.			
Dg.			
Bl.			
L.			
K.C.			
B.K.C.			
Ce.			
C.			
M.			
M.			
K.			
Mz.			
Mo.			
V.			
S.			
S.			
A			
R.			
P€.			
G.			
T.D.			

Loc. in Sec. C N½ N½ NE

Geol.

Contr. Stearns Drlg.

Pool

FIRST REPORT

JUL 17 '57

Date Comm. 7-13-57

8" @ 798/100 drlg. 1860

13

Co. Lse. No. Sec. T. R.

FORM 513 SUNRAY

County Russell Elev. 1773

Sec. 1 Twp. 15 Rge. 15

Company J. L. King etal.

Farm Name Schwein No. 1

TOPS	DEPTH	LOG	DATUM
Anh.	793		
Tp.			
H.	2911		
Tr.			
Dg.			
B.L.			
L.	2971		
K.C.			
B.K.C.			
Ce.			
C.			
M.			
M.			
K.			
Mz. Gorh sd	3207		
Mo.			
V.			
S.			
S.			
A			
R.			
P€.			
G.			
T.D.	3217		

Loc. in Sec. C N½ N½ NE

Geol.

Contr. Stearns Drlg

Pool

AUG 7 '57

ABANDONED

Date Comm. 7-13-57

8" 2 798/400 drlg. 1.60 JUL 24 '57

5½ 3217/100 WOCT JUL 31 '57 CO

3217½ $ 6 Bwph no time

AUG 6 '57 DD 3220 TD 24/3210

-16 $ Lots wt +SSO (1/2) $

Lots wt

D E C

Co. Lse. No. Sec. T. R.