


Kansas

Map No. _____ Sec. *23* Twp. *28* R. *5*

Well No. *5 Crawley* Farm _____
S. S. & S. Company _____

NORTH

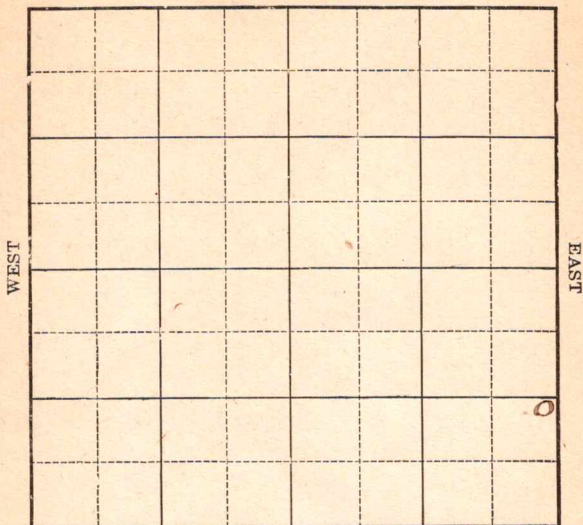

SOUTH

Location _____

Drilling Remarks:

Rig Up _____

Drilling Remarks:

RECORD

Cased _____ in. _____ ft.

Sand _____

Gas _____

Oil _____

Total Depth _____

PRODUCTION

1st 24 hrs. Nat. _____

1st 24 hrs. after shot _____

Gas _____ cu. ft.

Dry Hole _____

Abandoned _____

Map No. K11 Sec. 23 Twp. 28 R. 5

Well No. 5 Gawfey
S. S. & S. I. Company

Contractor

FIRST REPORT

SECTION PLAT

----- Ft. from N. Line

----- Ft. from S. Line

----- Ft. from E. Line

----- Ft. from W. Line

Location -----

Rig up -----

Drilling and Remarks:

L. O. Joo

RECORD

Cased ----- in., ----- ft.

Sand -----

Gas -----

Oil -----

Total Depth -----

PRODUCTION

1st 24 hrs. Nat. -----

1st 24 hrs. after shot -----

Gas ----- Cu. Ft.

Dry Hole -----

Abandoned -----

Date

MAR 12 1922

191

M. A. BENEAR

Scout

Map No. K11 Sec. 23 Twp. 28 R. 5Well No. 5, Craig

Company

Contractor

SECTION PLAT

Ft. from N. Line

1120 Ft. from S. Line200 Ft. from E. Line

Ft. from W. Line

COMPLETED

Location

Rig up

Drilling and Remarks:

sand 2761-2810shot 5 at120 lbs.

RECORD

Cased _____ in., _____ ft.

Sand _____

Gas _____

Oil _____

Total Depth _____

PRODUCTION

1st 24 hrs. Nat. _____

1st 24 hrs. after shot _____

Gas _____ Cu. Ft.

Dry Hole _____

Abandoned _____

Date

MAY 6 1922

M. A. BENEAR

Scout