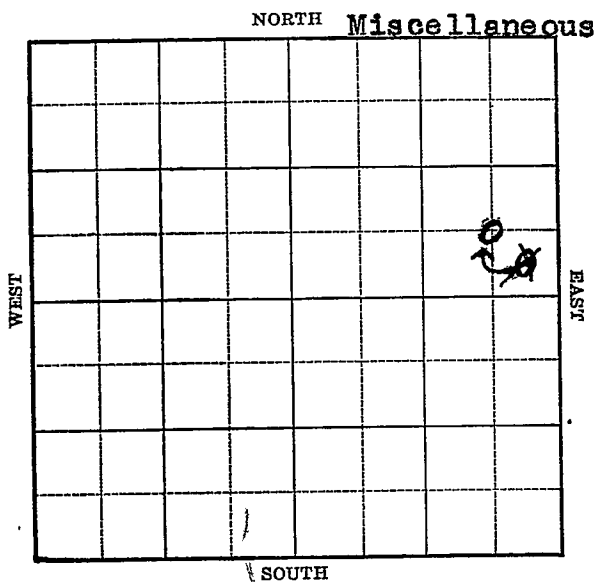


Section 8 Township 31 Range 7-EWell No. #1 CloverCompany J. L. Henderson, Jr.

Cowley

Map No. 3 Sec. 8 Twp. 31 R. 7EWell No. 1 CloverJ.L.Henderson jr.

Company

Contractor

FIRST REPORT

SE NE

 Ft. from N. Line330 Ft. from S. Line330 Ft. from E. Line Ft. from W. Line

MISCELLANEOUS

SECTION PLAT

Location Rig up

Drilling and Remarks:

Drig. 1400

RECORD

Cased in., ft.Sand Gas Oil Total Depth

PRODUCTION

1st 24 hrs. Nat. 1st 24 hrs. after shot Gas Cu. Ft.Dry Hole Abandoned

Date

JUN 21 1933 19S. J. LEWIS

Scot

Cowley

KANSAS

Map No. 3 Sec. 8 Twp. 31 R. 7EWell No. 1 CloverJ. L. Henderson Jr. Company

Contractor

CORRECTION

C SE NE

 Ft. from N. Line660 Ft. from S. Line660 Ft. from E. Line Ft. from W. Line

MISCELLANEOUS

SECTION PLAT

			o

Location Rig up

Drilling and Remarks:

Reported:

SE NE

RECORD

Cased in., ft.Sand Gas Oil Total Depth

PRODUCTION

1st 24 hrs. Nat. 1st 24 hrs. after shot Gas Cu. Ft.Dry-Hole Abandoned

Date

JUN 28 1939 19

S. J. LEWIS Scout

Cowley **KANSAS**Map No. 3 Sec. 8 Twp. 31 R. 7EWell No. 1 CloverJ. L. Henderson Company

Contractor

COMPLETE
C SE NE

SECTION PLAT

			o

 Ft. from N. Line660 Ft. from S. Line660 Ft. from E. Line Ft. from W. Line

MISCELLANEOUS

Location Rig up

Drilling and Remarks:

*KC2010**BKC2333**P.B2223**2,700,000 cu ft**Gas.*

RECORD

Cased in., ft.Sand Gas Oil Total Depth 2287

PRODUCTION

1st 24 hrs. Nat. 1st 24 hrs. after shot Gas Cu. Ft.Dry Hole Abandoned

Date

AUG 9 1939 19S. J. LEWIS Scout