
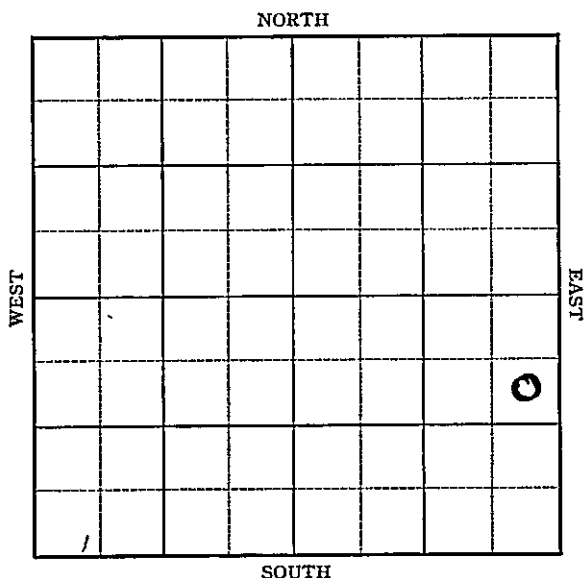


Section 36 Township 15 Range 14-WWell No. 2 - MichaelsiCompany Darby Pet.

Sec. 36 Twp. 15 R. 14-WWell No. #2 Michaelis FarmDarby Pet. Company990 Ft. from N. Line Ft. from S. Line330 Ft. from E. Line Ft. from W. Line

Elev. 1852

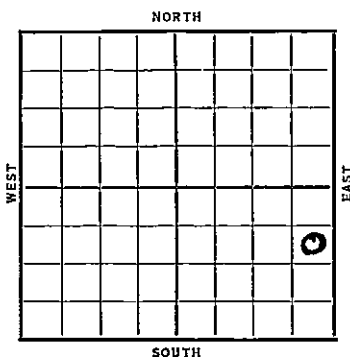

Date

REPORT

1937

6/9 Cellar

6/19 R U R

6/25 12" @ 518'. Drlg. 1685g.

7/2 K. C. 3036'. S.O. 3136039'.

Drlg. 3265'.

7/9 Sil. 3278'. 7" @ 3279'.

Drlg. 3319'.

7/14 7" @ 3279'.

5" liner 3320'.

Sil. 3278-81'.

Cherty Cong. 3281'.

Pay 3320-22'.

T.D. 3322'.

232½ bbls. 12 hrs.

Pot. 465 bbls.

COMPLETED

Russell KANSAS

Map No. 13 Sec. 36 Twp. 15 R. 14 WWell No. 2 MichaelisDarby Pet Company

Contractor

FIRST REPORT

SECTION PLAT

990 Ft. from N. Line1 Ft. from S. Line330 Ft. from E. Line Ft. from W. Line

			0

Location Rig up

Drilling and Remarks:

Cellar

RECORD

Cased in., ft.Sand Gas Oil Total Depth

PRODUCTION

1st 24 hrs. Nat. 1st 24 hrs. after shot Gas Cu. Ft.Dry Hole Abandoned

Date

JUN 9 1937 19

H. D. Hatfield Scout

Russell KANSAS

Map No. _____ Sec. 36 Twp. 15 R. 14 WWell No. 2-MichaelisDarby Pet Company

Contractor

COMPLETED

SECTION PLAT

990 Ft. from N. Line

_____ Ft. from S. Line

330 Ft. from E. Line

_____ Ft. from W. Line

			0

Location _____

Rig up _____

Drilling and Remarks:

232 1/2 / 12 hrsPOT - 465

7" - 3279
RECORD
 5" Liner in., 3320 ft.
 Sand Sil 3278-81
~~Cherty Cong~~ 3281
~~or Pay~~ 3320-22
 Total Depth 3322

PRODUCTION

1st 24 hrs. Nat. _____

1st 24 hrs. after shot _____

Gas _____ Cu. Ft.

Dry Hole _____

Abandoned _____

Date

JUL 14 1937 19H. D. Hatfield
Scout