

Map No. _____ Sec. 24 Twp. 28 R. 5


Well No. 1 Houston & Brook Farm _____
Johnson Eval Company _____

_____ Ft. from N. Line

200 Ft. from S. Line

200 Ft. from E. Line

_____ Ft. from W. Line

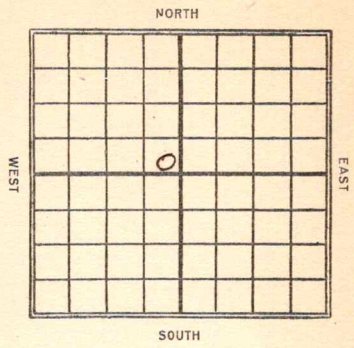

Date
1922

REPORT

10/26
1923

Rgn. up.
1/6 Sand 2726-51 - shot 20
gts. 30 lbs. oil. 5 lbs.
water. TD. 2756'

Map No. **KANSAS** Sec. **24** Twp. **28** R. **5**

Well No. **1 Houston & Brook**

Johnson et al Company

Contractor

FIRST REPORT

SECTION PLAT

----- Ft. from N. Line

200 Ft. from S. Line

200 Ft. from E. Line

----- Ft. from W. Line

RECORD

Location -----

Cased ----- in., ----- ft.

Rig up -----

Sand -----

Drilling and Remarks:

Gas -----

Oil -----

Total Depth -----

Rig up

PRODUCTION

1st 24 hrs. Nat. -----

1st 24 hrs. after shot -----

Gas ----- Cu. Ft.

Dry Hole -----

Abandoned -----

Date

OCT 26 1922

M. A. BENEAR

191

Scout

Map No. KANSAS 11 Sec. 24 Twp. 28 R. 5

Well No. 1 Houston & Brooks

Johnson et al Company

Contractor

COMPLETED SECTION PLAT

----- Ft. from N. Line

200 Ft. from S. Line

200 Ft. from E. Line

----- Ft. from W. Line

	0		

Location -----

Rig up -----

Drilling and Remarks:

*Plug back to
2751
shot 20 qts
30 lbs oil
6 lbs water*

RECORD

Cased ----- in., ----- ft.

Sand -----

Gas -----

Oil 2726-2751

Total Depth 2756

PRODUCTION

1st 24 hrs. Nat. -----

1st 24 hrs. after shot -----

Gas ----- Cu. Ft.

Dry Hole -----

Abandoned -----

Date

JAN 6 1923

M. A. BENEAR

191

Scout