


# Russell KANSAS

Form 51—5M—11-88—Palace

Section 36 Township 15 Range 14-W

Well No. #2 Dumbler

Company Coralena Trapp Pool

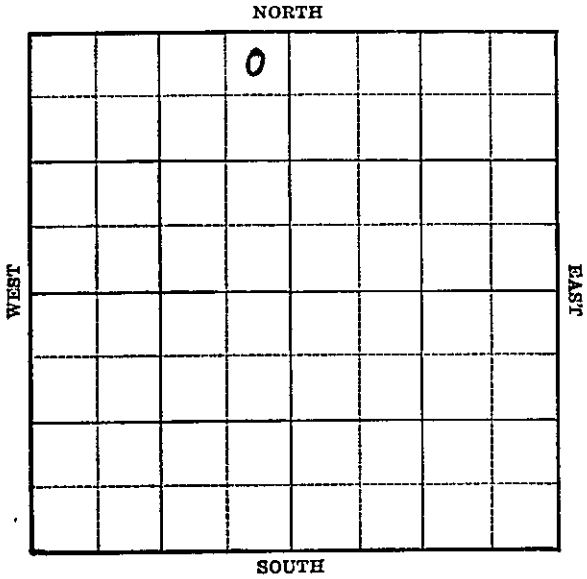



KANSAS

Russell

Map No. \_\_\_\_\_ Sec. **36** Twp. **15** R. **14W**Well No. **2 Dumbler****Coralena**

Company

Contractor

**FIRST REPORT****SECTION PLAT****NE NW****330** Ft. from N. Line

Ft. from S. Line

**330** Ft. from E. Line

Ft. from W. Line

|  |  |  |  |
|--|--|--|--|
|  |  |  |  |
|  |  |  |  |
|  |  |  |  |
|  |  |  |  |

**TRAPP POOL**Location **X**

Rig up \_\_\_\_\_

Drilling and Remarks: \_\_\_\_\_

**RECORD**

Cased \_\_\_\_\_ in., \_\_\_\_\_ ft.

Sand \_\_\_\_\_

Gas \_\_\_\_\_

Oil \_\_\_\_\_

Total Depth \_\_\_\_\_

**PRODUCTION**

1st 24 hrs. Nat. \_\_\_\_\_

1st 24 hrs. after shot \_\_\_\_\_

Gas \_\_\_\_\_ Cu. Ft.

Dry Hole \_\_\_\_\_

Abandoned \_\_\_\_\_

Date

**JUN 7 1939** 19**S. J. LEWIS** Scout

Map No. \_\_\_\_\_ Sec. 36 Twp. 15 R. 14WWell No. 2 DumblerCoralena

Company \_\_\_\_\_

Contractor \_\_\_\_\_

COMPLETED

## SECTION PLAT

NE NW

330 Ft. from N. Line

\_\_\_\_\_ Ft. from S. Line

330 Ft. from E. Line

\_\_\_\_\_ Ft. from W. Line

|  |  |  |  |
|--|--|--|--|
|  |  |  |  |
|  |  |  |  |
|  |  |  |  |
|  |  |  |  |
|  |  |  |  |

TRAPP POOL

Location \_\_\_\_\_

Rig up \_\_\_\_\_

Drilling and Remarks:

*Cu & 3292**7" @ 3295**2000 acid**Eckometer Pot.**1816*

## RECORD

Cased \_\_\_\_\_ in., \_\_\_\_\_ ft.

Sand \_\_\_\_\_

Gas \_\_\_\_\_

Oil \_\_\_\_\_

Total Depth 2317

## PRODUCTION

1st 24 hrs. Nat. \_\_\_\_\_

1st 24 hrs. after shot \_\_\_\_\_

Gas \_\_\_\_\_ Cu. Ft.

Dry Hole \_\_\_\_\_

Abandoned \_\_\_\_\_

Date

JUL 5 1939 19S. J. LEWIS Scout