

KANSAS

Cowley

Form 51-5M-7-39-Palace


Section 9 Township 31 Range 7-E

Well No. #1 Joe Aylward

Company Wixson et al

Misc.

NORTH

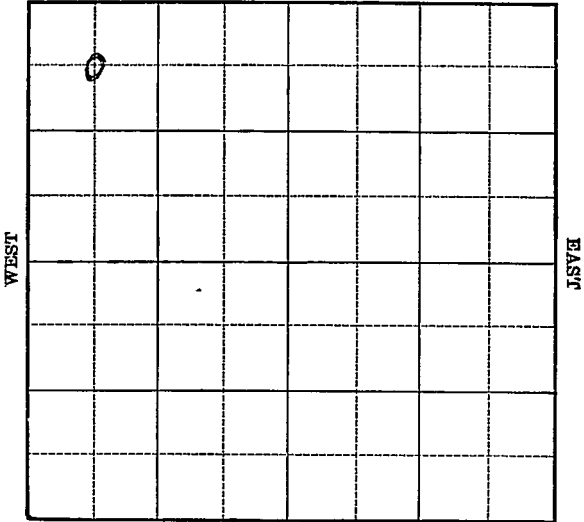

WEST

EAST

SOUTH

Sec. 9 Twp. 31 R. 7-E

Well No. #1 Joe Aylward Farm

Wixson et al Company


(Misc.)

660 Ft. from N. Line

_____ Ft. from S. Line

_____ Ft. from E. Line

660 Ft. from W. Line

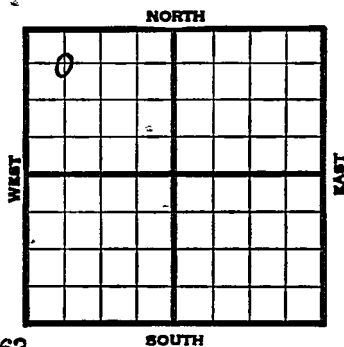

Elev. 1362

1939	REPORT
12/13	Location
12//21	"
12/28	"
1940	
1/4	"
1/11	"
1/18	R.U. Machine.
1/25	Shut down.
2/1	" "
2/8	Drlg. 350'
2/15	Drlg. 1010'
2/23	12" - 1200' Drlg. 1245'
2/29	10" - 1250' Drlg. 1480'
3/8	8" - 1552' Drlg. 1810'
3/14	8" - 1710' 6" - 2048'
	Drlg. 2060'
3/21	K. C. 2027' SO 2035-40'
	6" - 2048' TD 2330' SD.
3/28	" " " " "
4/4	" " " " "
4/12	8-5/8" - 128' Drlg. 2010'

OVER

1940

4/18

Miss. 2787'
TD 2851' SD.

4/25

" "

5/1

Miss. 2787'
6" - 20.48'
T.D. 2851'
400,000 cu. ft. gas.

COMPLETED

Map No. 3 Sec. 9 Twp. 31 R. 7E

Well No. 1 Joe Aylward

Wixson etal Company

Contractor

FIRST REPORT

C NW NW

660 Ft. from N. Line

_____ Ft. from S. Line

_____ Ft. from E. Line

660 Ft. from W. Line

SECTION PLAT

o			

MISCELLANEOUS

Location X

Rig up _____

Drilling and Remarks:

RECORD

Cased _____ in., _____ ft.

Sand _____

Gas _____

Oil _____

Total Depth _____

PRODUCTION

1st 24 hrs. Nat. _____

1st 24 hrs. after shot _____

Gas _____ Cu. Ft.

Dry Hole _____

Abandoned _____

Date

[_____ 19 _____

S. J. LEWIS Scout

Cowley

Map No. 3 Sec. 9 Twp. 31 R. 7E

Well No. 1 Joe Aylward

Wixson etal Company

Contractor

COMPLETED

C NW NW

SECTION PLAT

o			

660 Ft. from N. Line

_____ Ft. from S. Line

_____ Ft. from E. Line

660 Ft. from W. Line

MISCELLANEOUS

Location _____

Rig up _____

Drilling and Remarks:

Miss 2787

6' @ 2048.

400,000 gas

RECORD

Cased _____ in., _____ ft.

Sand _____

Gas _____

Oil _____

Total Depth 2851

PRODUCTION

1st 24 hrs. Nat. _____

1st 24 hrs. after shot _____

Gas _____ Cu. Ft.

Dry Hole _____

Abandoned _____

Date

MAY 1 1940 19

S. J. LEWIS

Scout