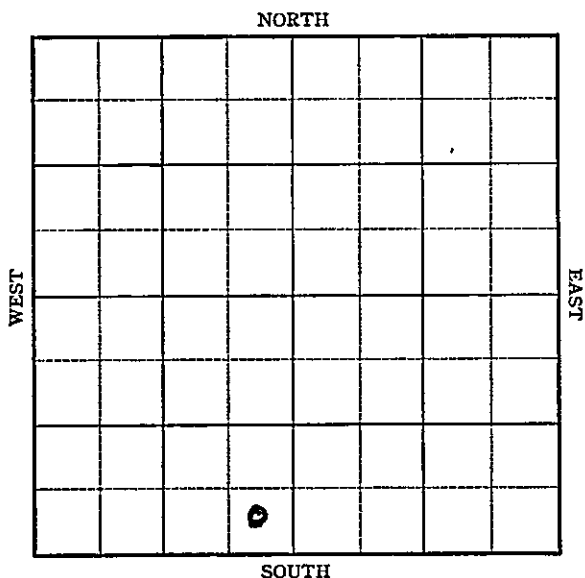


KANSAS

Russell

Section 36 Township 15 Range 14-WWell No. 2 DumlerCompany Shell

Sec. 36 Twp. 15 R. 14 - V

Well No. #2 Dumlér Farm _____
Shell Company _____


Ft. from N. Line

330¹ Ft. from S. Line

330 Ft. from E. Line

Ft. from W. Line

Elev. 1870

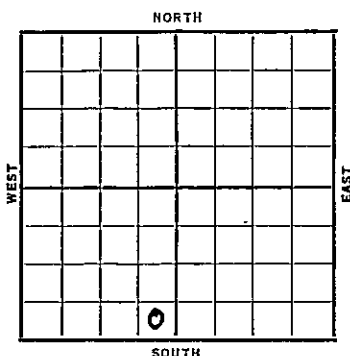

Date	REPORT
1937	
12/8	B.R.R.
12/17	10" @ 613'. WOC.
12/24	Topeka 2779'. Drlg. 2998'.
12/31	K.C. 3080'. Stain oil 3080-85'.
	Arb. 3296'. T.D. 3301'.
	Sat. core. 7" @ 3297'. RUST.
1938	
1/7	T.D. 3311'. 2400' oil 4 hrs. Swab 57 bbls. oil 1 hr. 4000 acid.
1/14	Swab 868 oil in 6 hrs. 5000 acid. Deepened to 3321'. Swab 204 oil in 4 hrs. 4000 acid.
1/20	T.D. 3321' Testing.
	OVER

1938

1/26 7" @ 3297'.

Arb. 3296'.

T.D. 3321'.

Total 13,000 acid.

Potential 959 bbls.

COMPLETED

Russell

KANSAS

Map No. _____ Sec. 36 Twp. 15 R. 14WWell No. 2 DumlerShell

Company

Contractor

FIRST REPORT

SE SW

_____ Ft. from N. Line

330 Ft. from S. Line330 Ft. from E. Line

_____ Ft. from W. Line

SECTION PLAT

Location _____

Rig up _____

Drilling and Remarks:

BRR

RECORD

Cased _____ in., _____ ft.

Sand _____

Gas _____

Oil _____

Total Depth _____

PRODUCTION

1st 24 hrs. Nat. _____

1st 24 hrs. after shot _____

Gas _____ Cu. Ft.

Dry Hole _____

Abandoned _____

Date

DEC 8 - 1937

19

H. D. Hatfield

Scout

KANSAS

Russell

Map No. _____ Sec. 36 Twp. 15 R. 14WWell No. 2 DumlérShell Company

Contractor

COMPLETED
SE SW

SECTION PLAT

_____ Ft. from N. Line

330 Ft. from S. Line330 Ft. from E. Line

_____ Ft. from W. Line

Location _____

Rig up _____

Drilling and Remarks:

13,000 and - TotalPT 959

RECORD

Cased 7 in., 3297 ft.Sand Ark 3296

Gas _____

Oil _____

Total Depth 3321

PRODUCTION

1st 24 hrs. Nat. _____

1st 24 hrs. after shot _____

Gas _____ Cu. Ft.

Dry Hole _____

Abandoned _____

Date

JAN 26 1938 19H. D. Hatfield Scout