


Section 24 Township 28 Range 5 E

Well No. # 1 Heidi

Company Eckland Drlg.

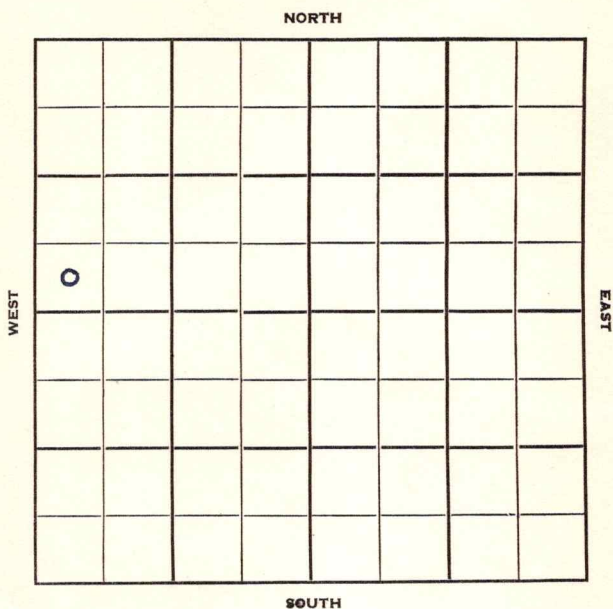

Butler

KANSAS

Sec. 24 Twp. 28 R. 5E ✓

Well No. #1 Heidi Farm

Eckland Drlg. Company

Contractor


330' Ft. from N. Line

_____ Ft. from S. Line

_____ Ft. from E. Line

330' Ft. from W. Line

SW SW NW

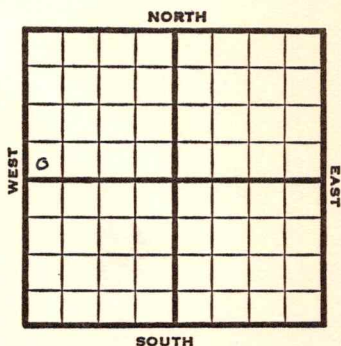

1951

Elev. 1355'

REPORT

3/14

8" @ 90'

RTD 2808

5" @ 2808'

6/6

D & A TD 2811'

8" @ 90'

Bart. 2791'

5" @ 2804'

TD 2808'

HFW

DD 2811'

10 qt/

FU 800' water

D & A

ABANDONED

County Butler State KansasSec. 24 (Blk. 28 (Sur. 5E Map No. 5E)
(Twp.) (Rge.)Operator Eckland Drlg.Well No. 1 Farm HeidiElev. Location SW SW NW

330 Ft. From N Line NW330 Ft. From W Line Quarter1st. Report MAR 14 1951Completion Remarks Spudding Date Drlg. Data 8" @ 90 RTD 2808 5" @ 2808

J. E. TYRA

County

Butler

State

Kansas

Sec.

24

(Blk.)
(Twp.)

28

(Sur.)
(Rge.)

5E

Map No.

Operator

Eckland Drlg.

Well No.

1

Farm

Heidi

Elev.

1355

Location

SW SW NW

330 Ft. From N Line NW

330 Ft. From W Line Quarter

1st. Report

Completion JUN 6 1951

Remarks

Spudding Date _____

Drlg. Data

D & A

TD 2811

811 @ 90

Bart. 2791

5" @ 2804

TD 2808

HFW

DD 2811

10 qt/

FU 800! water

D & A