

Map No. Kan. Sec. 13 Twp. 31 R. 7

Well No. 1 Brown Farm


Empire G. & T. Co Company

_____ Ft. from N. Line

1020 Ft. from S. Line

_____ Ft. from E. Line

1020 Ft. from W. Line

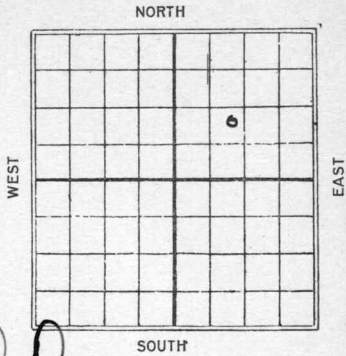

O.W.D.D.

Date	REPORT
<u>1925</u>	
<u>7/10</u>	<u>log 6" cas. @ 2754</u>
<u>7/17</u>	<u>Going to second brake</u>
<u>7/24</u>	<u>2850</u>
<u>7/31</u>	<u>—</u>
<u>8/7</u>	<u>2930'</u>
<u>8/14</u>	<u>7515 3107'</u>
<u>8/20</u>	<u>3303'</u>
<u>8/27</u>	<u>—</u>
<u>9/3</u>	<u>Abandoned 3364</u>

3 1/2 *1/2* *1/3* Twp. *31* R. *7*
 Map No. _____ Sec. _____ Twp. _____ R. _____

1 *Blowdown*
 Well No. _____

Empire Oil & Gas Co.
 _____ Company

_____ Contractor

FIRST REPORTS

SECTION PLAT

_____ Ft. from N. Line

1020 _____ Ft. from S. Line

_____ Ft. from E. Line

1020 _____ Ft. from W. Line

		0	

going to 2nd brand.

Location _____

Rig up _____

Drilling and Remarks:

old well deeper.

Fishing 6' by

LD 2754,

RECORD

Cased _____ in., _____ ft.

Sand _____

Gas _____

Oil _____

Total Depth _____

PRODUCTION

1st 24 hrs. Nat. _____

1st 24 hrs. after shot _____

Gas _____ Cu. Ft.

Dry Hole _____

Abandoned _____

Date

JUL 10 1925

CHAS. L. SHERWOOD

192

Scout

Cowley Co

Map No. ³ KANSAS Sec. 13 Twp. 31 R. 7

Well No. 1 Brown

Com pit 94 1/2 Co Company

Contractor

COMPLETED

SECTION PLAT

_____ Ft. from N. Line

1020 _____ Ft. from S. Line

_____ Ft. from E. Line

1020 _____ Ft. from W. Line

		○	

ABANDONED

Location _____

Rig up _____

Drilling and Remarks:

Dry 2 hrs
20. 3364'

RECORD

Cased _____ in., _____ ft.

Sand _____

Gas _____

Oil _____

Total Depth 3364'

PRODUCTION

1st 24 hrs. Nat. _____

1st 24 hrs. after shot _____

Gas _____ Cu. Ft.

Dry Hole ✓

Abandoned ✓

Date

SEP 3 1925

192

CHAS. L. SHERWOOD

Scout