


SECTION 13 TOWNSHIP 31 RANGE 7E

WELL NO. #1 Harlan

COMPANY Stelbar Oil Corp.

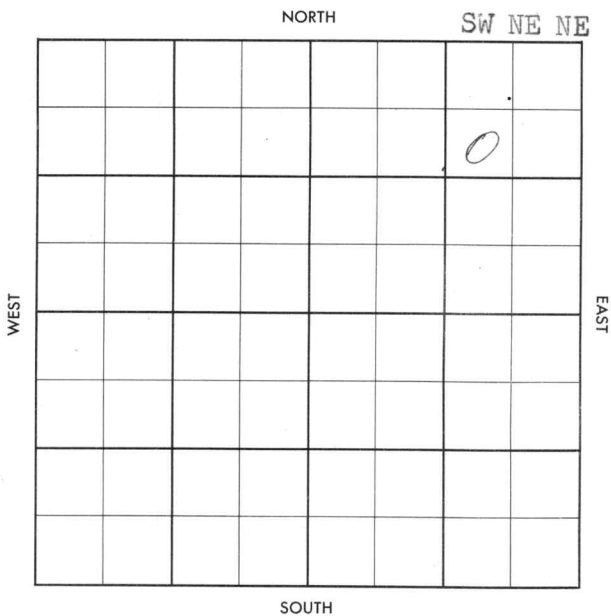

County Cowley Elev. _____
 Sec. 13 Twp. 31 Rge. 7E
 Company Stelbar Oil Corp.
 Farm Name Harlan No. 1

Co.

TOPS	DEPTH	LOG	DATUM
Anh.			
Tp.			
H.			
Tr.			
Dg.			
BL.			
L.			
K.C.			
B.K.C.			
Ce.			
C.			
M.			
M.			
K.			
Mz.			
Me.			
V.			
S.			
S.			
A.			
R.			
PE.			
G.			
T.D.			

Loc. in Sec. SW NE NE

Geol. _____
Contr. Prairie O & G

Pool Brown

		0
	MAY 8 37	

FIRST REPORT

Lse

Not

Date Comm. _____
Location _____

Sec.

T.

R.

~~30~~

1429

County Cowley Elev. 1436
 Sec. 13 Twp. 31 Rgn. 7E
 Company Stelbar Oil Corp.
 Farm Name Harlan No. 1

TOPS	DEPTH	LOG	DATUM	Loc. in Sec.
Anh.				SW NE NE
TP.				
H. <u>Log</u>	<u>2016</u>			
Tr.				
Dg.				
BL.				
L.				
K.C.	<u>2042</u>			Geol.
B.K.C.	<u>2242</u>			Contr.
Ce. <u>clev.</u>	<u>2316</u>			Prairie O & C
C. <u>Pawn</u>	<u>2350</u>			Pool
M. <u>FTSCT</u>	<u>2439</u>			Brown
M. <u>ce</u>	<u>2494</u>			
K. <u>Bartl.</u>	<u>2657</u>			
Mz. <u>MISS</u>	<u>2798</u>			
Mq.				
V.				
S.				
S.				
A.				
R.				
PE.				
G.				
TD.	<u>2855</u>			

MAY 29 57	0
ABANDONED	

Date Comm. _____
 Location MAY 15 57 5-10-57 85/8
172/120 crd 2000-42 Full rec.
2042 MAY 22 57 MAY 29 57 X L-KC 2042
DST 2199-2210 crd 1 in G/22" rec.
80' GCM + 25' WM FP 0-20 BHP
255/30" BKC 2242 clev. 2316 Pawn
2350 FTSCT 2439 ce 2494 Bartl.
2657 crd 2681-2724 Full rec. no
sd MISS ~~2681~~ (2798) 2798

DST 2797-2808 cr 80" net 30'
Md + Trace oil BHPD RTD
2855 Ran Log

DEA