

Cowley

KANSAS

SECTION 19 TOWNSHIP \_\_\_\_\_ RANGE 7E

WELL NO. #1 Varner

COMPANY Zack Dean Oil

NORTH


WEST

EAST

SOUTH

# HOT FILE Cowley

KANSAS

SEC. 19 TWP. 31 R. 7 E

WELL NO.

#1 Varner

FARM

COMPANY

Zack Dean Oil

~~Z. W. Dean & Lloyd Youmans~~

CONTRACTOR

Kriswell Drlg. Co.


Wildcat

\_\_\_\_\_ Ft. from N. Line

\_\_\_\_\_ Ft. from S. Line

\_\_\_\_\_ Ft. from E. Line

\_\_\_\_\_ Ft. from W. Line

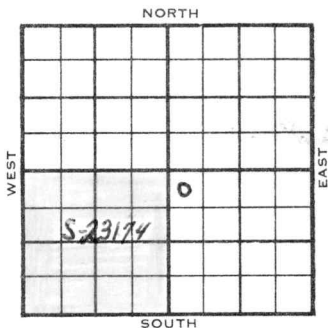

NW NW SE

SDX DHC \$2000.00

Lse. (S-23174)

ELEVATION

REPORT

1956

(WH6-DC26)

3/15

Mississippi Lime test well @3000'  
To be commenced by April 2, 1956  
To be completed by May 2, 1956  
(See DHC Ltr. 3-14-56)

4/13

Spud 4-14-56.  
Set 83' of 8-5/8" w/70 sks.  
Moving in rotary (Card-Kriswell)

4/15

Drlg. 530' "

4/16

Drlg. 1320' (FR TME)

4/17

Drlg. 1825' Stall 1707' "

4/18

Drlg. 2185' Lsg. 1877 "

4/19

Drlg. 2375' Lay. 2116'  
DST #1, 2248-2260' open 1 hr,  
closed 1/2 hr, 15' very slightly oil  
cut mud. weak blow. IFP Off. FFP Off.  
BHP 45# (Card-Kriswell)

4/20

BKC 2384' KC 2153' "

4/21

Drlg. 2706'  
Drlg. 2955'  
DST #2, 2896-2908', open 1/2 hr,  
closed 20 min, very weak 10 min blow,  
8' slightly oil cut mud. IFP Off.  
FFP Off. BHP 45# (Card-Kriswell)

4/22

TD 3010'. D & A "

4/24

Advised Contract Section - D & A

4-25

D&A TD 3010' Ce. 2636' **ABANDONED**  
OSW. 2568' M. 2894' 2891'  
Marm 2480'

County Cowley Elev. \_\_\_\_\_  
 Sec. 19 Twp. 31 Rge. 7E  
 Company Zack Dean Oil  
 Farm Name Varner No. 1

TOPS	DEPTH	LOG	DATUM	Loc. in Sec.
Anh.				NW NW SE
TP.				
H.				
Tr.				
Dg.				
BL.				
L.				Geol. _____
K.C.				Contr. _____
B.K.C.				<b>Krisswell</b>
Ce.				
C.				Pool _____
M.				<b>Wildcat</b>
M.				
K.				
Mz.				
Ma.				
V.				
S.				
S.				
A.				
R.				
PE.				
G.				
T.D.				

FIRST REPORT

APR 18 '66

Date Comm. 4-14-56 Sunray Mid-Continent DHM  
8" @ 88 drlg. 1451

APR 5 0 1966

M.M.

County Conley Elev. \_\_\_\_\_  
 Sec. 19 Twp. 31 Rge. 7E  
 Company Back Lean Oil  
 Farm Name Warner No. 1

TOPS	DEPTH	LOG	DATUM
Anb. <u>Stall</u>		<u>1707</u>	
TP.			
H. <u>Lay</u>		<u>2116</u>	
Tr.			
Dg.			
Bl. <u>L59</u>		<u>1877</u>	
#. <u>K.C.</u>		<u>2153</u>	
K.C.			
B.K.C.		<u>2384</u>	
Ce. <u>Marm</u>		<u>2480</u>	
C. <u>OSW.</u>		<u>2568</u>	
M. <u>2894</u>	<u>2894</u>	<u>2891</u>	
#. <u>CG</u>		<u>2636</u>	
K.			
Mz.			
Me.			
V.			
S.			
S.			
A.			
R.			
PE.			
G.			
TD.	<u>3010</u>		

Loc. in Sec. \_\_\_\_\_  
 Geol. \_\_\_\_\_  
 Contr. Kriswell  
 Pool Wildcat

ABANDONED  
 APR 25 1956

Date Comm. 4-14-56 Sunray Ltd - Continent Dr

8" e 88 dirg. 1451

DST 2248-60 exp 1 hr rec 15'  
VSOCM FPO BHP 45/30" MISS.  
2894 DST 2896-2909 exp 30"  
rec 8' SOCM FPO BHP 8/30"

DEA

Co.  
 L. Se.  
 No.  
 T.  
 R.