


Section 21 Township 15 Range 15W

Well No. #1 Janne

Company Shelly & Miller

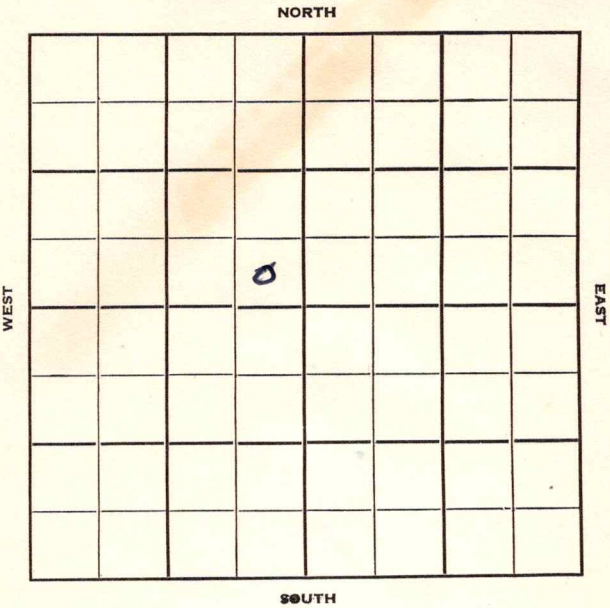

Russell

KANSAS

Sec. 21 Twp. 15 R. 15 W

Well No. # 1 Janne Farm

Shelly & Miller Company

Shelly Contractor


Wildcat

 Ft. from N. Line

330 Ft. from S. Line

330 Ft. from E. Line

 Ft. from W. Line

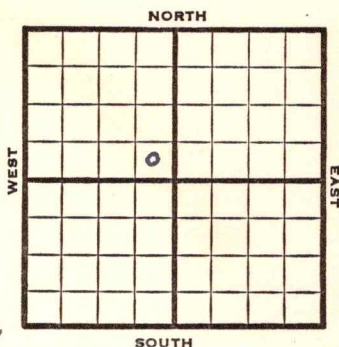

SE SE NW

Lion & Sunray - support

1952 **Elev. 1851'** REPORT

8/6 Spud 8-3-52
8" @ 770'
Drlg. 1850'


8/13 Spud 8-3-52
D&A TD 3395'
8" @ 770'

Anhy 923 **Tar. 2535**
Heeb. 3055 **Lans. 3114**
Cong. 3349 **Arb. 3364**
DST 3364-70 open 20 min.
rec. 10' mud TD 3395' D&A

ABANDONED

County Russell State Kansas
 Sec. 21 (Blk. Twp.) 15 (Sur. Rge.) 15W Map No.
 Operator Shelly & Miller
 Well No. 1 Farm Janne

Elev. _____ Location SE SE NW

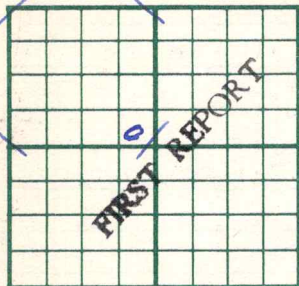

330 Ft. From S Line NW

330 Ft. From E Line Quarter

1st. Report AUG 6 1952

Completion _____

Remarks Lion & Sunray-
support

Shelly-Contr.
 Spudding Date 8-3-52

Drlg. Data Wildcat

8" @ 770 Drlg. 1850


J. G. McGEHEE

County Russell State Kansas
 Sec. 21 (Blk.) 15 (Sur.) 15W Map No.

Operator Shelly & Miller

Well No. 1 Farm Janne

Elev. 1851 Location SE SE NW

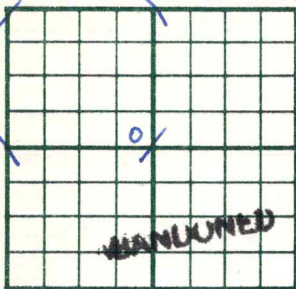

330 Ft. From S Line NW

330 Ft. From E Line Quarter

1st. Report

Completion AUG 13 1952

Remarks Wildcat

Shelly - Contr.

Spudding Date 8-3-52

Drlg. Data D & A TD 3395

8" @ 770 Anhy 923 Tarkio 2535

Heeb. 3055 Lans. 3114 Cong. 3349

Arb. 3364 DST 3364-70 open 20 min.

Rec. 10' mud TD 3395

D & A