


Section 15 Township 31 Range 7 E

Well No. # 1 Fox

Company Royal Oil

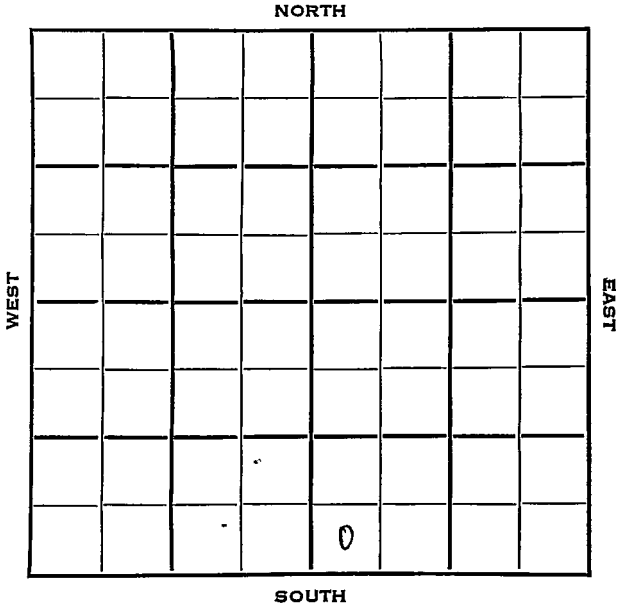

Cowley KANSAS

| | | |
|------|------|------|
| SEC. | TWP. | R. |
| 15 | 31 | 7E ✓ |

WELL NO. 1 Fox FARM

COMPANY

Royal Oil

CONTRACTOR

Krisswell Drlg.


Wildcat

_____ Ft. from N. Line

330 _____ Ft. from S. Line

_____ Ft. from E. Line

330 _____ Ft. from W. Line

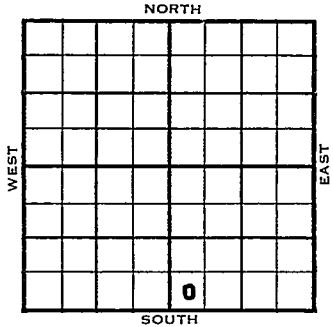

SW SW SE

| | | |
|------|--------------------|--------|
| 1953 | ELEVATION 1336' | REPORT |
|------|--------------------|--------|

12/22 Spud 12-19-53
8" @ 75'
Drlg. 1385'

1954
1/6 Spud 12-19-53
D&A
TD 2830'
8" @ 75'
KC 2131', ⁰swego 2464', Miss 2802'
TD 2830'
D&A

ABANDONED

