


Russell

KANSAS

SECTION 13 TOWNSHIP 15S RANGE 15W

WELL NO. #1 DeWald

COMPANY Alkay Oil Co.

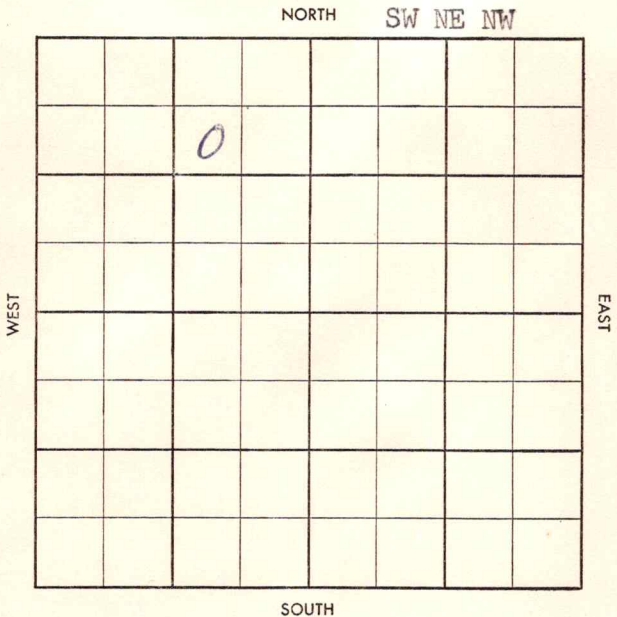

WILDCAT ✓13

S-513-A

CO. Russell ELEV. _____

SEC. 13 TWP. 15 RGE. 15W

COMPANY Alkay Oil Co. NO. 1

DEC 11 57

FIRST REPORT

FARM DeWald

LOC. SW NE NW

X

GEOL. D. Vaughan

CONTR. Triangle tools

POOL Wildcat

SPUD 12/6/57

8" @ 536 w/300 Drlg.
2350

CO.

LSE.

NO.

SEC.

TWP.

RGE.

CO. Russell ELEV. 1833SEC. 13 TWP. 15 RGE. 15WCOMPANY Alkay Oil Co, NO. 1

ABANDONED

FARM DeWaldLOC. SW NE NWGEOL. D. VaughanCONTR. Triangle toolsPOOL WildcatSPUD 12/6/57

8" x 536 w/300 Drif.

2350 DEC 18 57 A 970TP 2772 H 3003TR 3020 L 3068C 3300 A-63305RTD 3335no logD & A