


Section 21 Township 15 Range 15-W

Well Number 1-Steinert

Company Lario et al

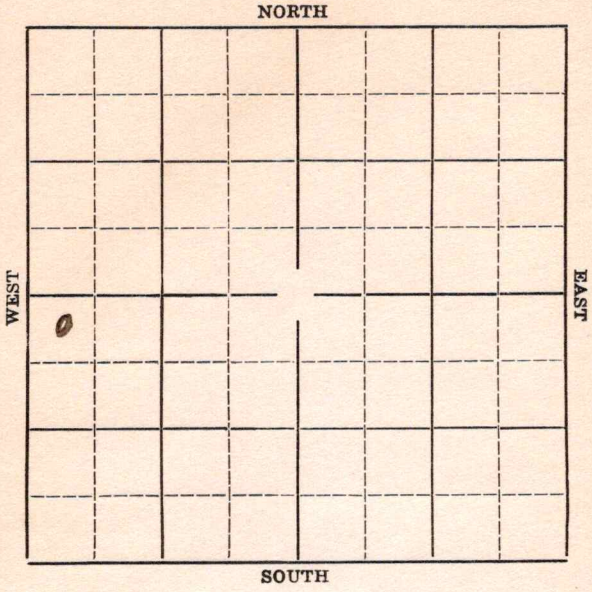

Map No. _____ Sec. **21** Twp. **15** R. **15W**

Well No. **#1 Steinert** Farm _____

Lario et al Company _____


330' Ft. from N. Line

_____ Ft. from S. Line

_____ Ft. from E. Line

330' Ft. from W. Line

Elev. 1816

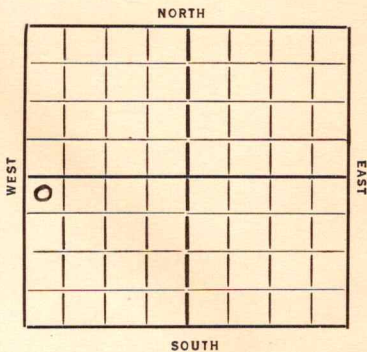

Date **1936**

REPORT

4/29 Location

5/7 Ponds.

5/14 Rig on ground.

5/21 Rigging up.

5/28 Drlg. 326'.

6/4 590' Cleaning out.

6/11 **Anhydrate 875'**. Drlg. 883'.

6/18 Drlg. 1714'.

6/25 Drlg. 2250'.

7/2 Drlg. 2586'.

7/9 2625'. Under ream 8".

7/16 8" @ 2781'. Drlg. 2791'.

7/23 **Topeka 2775'**. **Lansing 3060'**.

6" @ 3060'. T.D. 3095'. 2100' oil in hole.

7/30 2000 gallons of acid. Swabbing 16 bbls of oil per hour.

8/5/36 - **Lansing 3060'**.

T.D. 3095'. 2000 gal acid.

Pot. 729 bbls of oil 20% water. 37. Gravity. **COMPLETED**

3060
1816
1244

Map No. 73 Sec. 21 Twp. 15 R. 15

Well No. 1 Steiner

Lario & Co Company

Contractor

SECTION PLAT

330 Ft. from N. Line

..... Ft. from S. Line

..... Ft. from E. Line

330 Ft. from W. Line

0			

FIRST REPORT

Location ✓

Rig up

Drilling and Remarks:

RECORD

Cased.....in.,ft.

Sand.....

Gas.....

Oil.....

Total Depth.....

PRODUCTION

1st 24 hrs. Nat.....

1st 24 hrs. after shot.....

Gas.....Cu. Ft.

Dry Hole.....

Abandoned.....

Date

APR 29 1936

S. J. LEWIS

192.....

Scout

KANSAS

Form 26-1M Bks. 2-29

Map No. 73 Sec. 21 Twp. 15 R. 15W

Well No. Steiner

Lario Oil Company

Contractor

SECTION PLAT

0			

330 Ft. from N. Line

_____ Ft. from S. Line

_____ Ft. from E. Line

330 Ft. from W. Line

COMPLETED

Location _____

Rig up _____

Drilling and Remarks:

hanging 3060
2000 gal
2 1/2 729 oil
20% water
87° Gravity

RECORD

Cased _____ in., _____ ft.

Sand _____

Gas _____

Oil _____

Total Depth 3095

PRODUCTION

1st 24 hrs. Nat. _____

1st 24 hrs. after shot _____

Gas _____ Cu. Ft.

Dry Hole _____

Abandoned _____

Date

AUG 5 1936¹⁹

S. J. LEWIS

Scout