


SECTION 21 TOWNSHIP 15 RANGE 15W

WELL NO. #1 Steinert

COMPANY Nelmar Development Co.

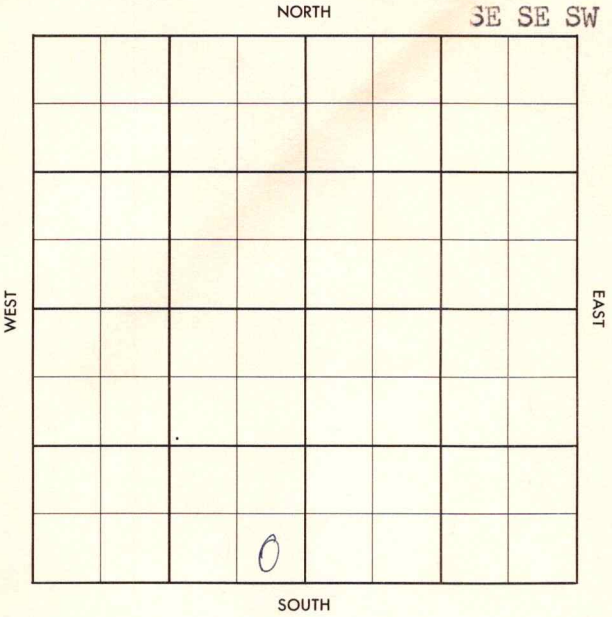

County Russell Elev. 1888  
 Sec. 21 Twp. 15 Rge. 15W  
 Company Nelmar Development Co.  
 Farm Name Steinert No. 1

TOPS	DEPTH	LOG	DATUM	Loc. in Sec.
Anh.				SE SE SW
Tp.	2845			
H.	3073			
Tr.	3093			
Dg.				
BL.				
L.	3132			Geol.
K.C.				Contr.
B.K.C.				Haynes
Ce.				Pool
C.				
M.				
M.				
K.				
Mz.				
Ma.				
V.				
S.				
S.				
A.				
R.				
PE.				
G.				
TR.	3262			

ABANDONED  
 JUL 17 '57  
 0

Date Comm. \_\_\_\_\_  
 Location MAY 15 '57 5-9-57 8278  
300/200 2500 MAY 22 '57 PIPE  
set. MAY 23 '57 DST 3208-3216  
1100' GIR rec 110' 9554 oil + 100'  
MW BHP 697/20" FP 41-94  
4 1/2" @ 3261 CO PF 25/3224-28  
25/3212-16 550 1 1/2" + 1 1/2" BopL  
+ 12% wt PB 3200 8/3170-73  
8/3164-66 4/3159-60 8/3154-56

A tstd. dry 50g All PFIS

JUN 2 '57 T&R (no dope) JUN 17 '57

REF 813213-15 no tstd

A \$ 8 B0 + 16 BW in

6 hrs T&R JUN 19 '57 ✓ JUN 26 '57

JUL 3 '57 JUL 10 '57 JUL 17 '57

D&R

County Russell Elev. \_\_\_\_\_  
 Sec. 21 Twp. 15 Rge. 15W  
 Company Nelmar Development Co.  
 Farm Name Steinert No. 1

TOPS	DEPTH	LOG	DATUM
Anh.			
Tp.			
H.			
Tr.			
Dg.			
Bl.			
L.			
K.C.			
B.K.C.			
Ce.			
C.			
M.			
M.			
K.			
Mz.			
Me.			
V.			
S.			
S.			
A.			
R.			
PE.			
G.			
T.D.			

Loc. in Sec. SE SE SW  
 Geol. \_\_\_\_\_  
 Contr. Haynes  
 Pool \_\_\_\_\_

FIRST REPORT  
 MAY 8 '57  
 0

Date Comm. \_\_\_\_\_  
 Location Location

~~13~~

Co.  
 Lse.  
 No.  
 Sec.  
 T.  
 R.