


Section 21 Township 15 Range 15W

Well No. #1 Steinert

Company Lohman & Johnson

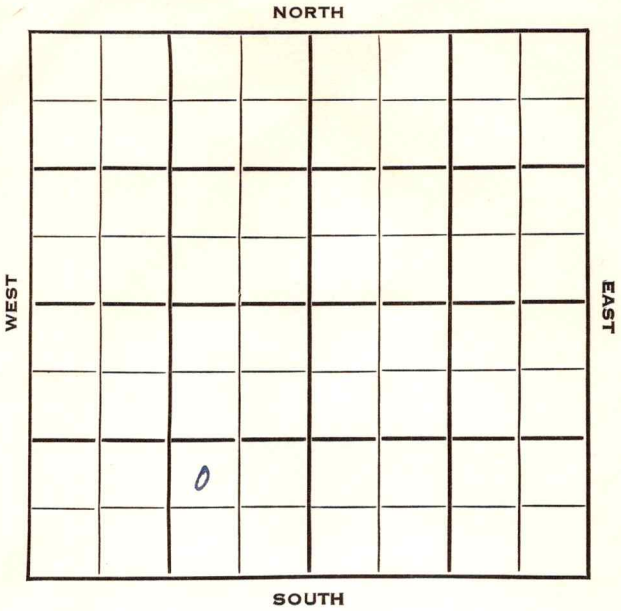

SEC.	TWP.	R.
21	15	15W ✓

WELL NO.

1 Steinert

FARM

COMPANY

Lohman & Johnson

CONTRACTOR

Wildcat


_____ Ft. from N. Line

990 _____ Ft. from S. Line

990 _____ Ft. from E. Line

_____ Ft. from W. Line

NW SE SW

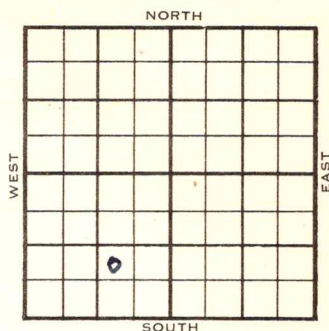

	ELEVATION	REPORT
1954	1866'	

3/10	Spud 2-26-54 8" @ 228' Anhy 915', Heeb 3056', KC 3110' DST 3085-3125', opn 3/4 hrs., rec. 31' mud, 770# DST 3282-3305', opn 1 hr., rec. 10' socm, 0#
3/17	Cong 3347', Arb. 3370' RTD 3376' 5" @ 3160'
3/24	NR
5/26	Spud 2-26-54 Oil Well TD 3376' 8" @ 228' Anhy 915', Heeb 3056', KC XX 3110' DST 3085-3125', opn 3/4 hrs., rec. 31' mud, 770# DST 3282-3305', opn 1 hr., rec. 10' socm, 0# Cong 3347', Arb. 3370' TD 3376' 5" @ 3160' CO to 3155', 15/3141-44, 1000A S/2½ boph 15% wtr., 8 hrs.

(Information Brought Forward)

1954
5/26

PB 3130'
15/3111-14, 10/3118-20
FU 200' oil & wtr.
S/2 bfph 1000A
CO to 3155'
Comp. 10 bopd

COMPLETED

J. G. McGEHEE

