

Butler

KANSAS

SECTION 24 TOWNSHIP 28 RANGE 5E

WELL NO. #6 Kinglsey

COMPANY Eckland Drlg.

NORTH

WEST

EAST


SOUTH

SEC. 24	TWP. 28	R. 5E
------------	------------	----------

WELL NO.

#6 Kingsley

FARM

COMPANY

Eckland Drlg.

CONTRACTOR


Fox-Bush

\_\_\_\_\_ Ft. from N. Line

\_\_\_\_\_ Ft. from S. Line

\_\_\_\_\_ Ft. from E. Line

\_\_\_\_\_ Ft. from W. Line

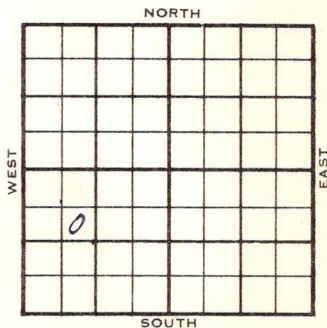

SE NW SW

1956

ELEVATION

1371'

REPORT

4-11

Comm. 4-2-56  
Surface Set.

5-9

8 5/8" @ 300

5 1/2" @ 2799

CO 2780, 18/ 2747-50, frac

CO 2780, frac

P/ 15 bopd, no/wtr.

Bartl. 2747

TD 2800'

COMPLETED

County Butler Elev. 1371  
 Sec. 24 Twp. 28 Rge. 5E  
 Company Eckland Drig.  
 Farm Name Kinsley No. 6

TOPS	DEPTH	LOG	DATUM	Loc. in Sec.
Anh.				SE NW SW
Tp.				
H.				
Tr. <u>Bartl.</u>	<u>2747</u>			
Dg.				
Bl.				
L.				Geol.
K.C.				Contr.
B.K.C.				
Ce.				
C.				
M.				
M.				Pool
K.				<u>Fox-Bush</u>
Mz.				
Me.				
V.				
S.				
S.				COMPLETE
A.				
R.				
PE.				
G.				
TD.	<u>2800</u>			

Date Comm. 4-2-56 MAY 9 1956

surface set APR 18 '56 85/8 300 5 1/2  
2799 CO 2780 18 / 2747-50  
 Frac APR 25 '56 split cs9 50d co.  
 MAY 2 '56 CO 2780 Frac MAY 10 '56 P.  
15 Bopd no / wtr

County Butler Elev. \_\_\_\_\_  
 Sec. 24 Twp. 20 Rgs. 5E  
 Company Eckland Drig.  
 Farm Name Kingsley No. 6

TOPS	DEPTH	LOG	DATUM
Anh.			
Tp.			
H.			
Tr.			
Dg.			
Bl.			
L.			
K.C.			
B.K.C.			
Ce.			
C.			
M.			
M.			
K.			
Mz.			
Mq.			
V.			
S.			
S.			
A.			
R.			
Pe.			
G.			
T.D.			

Loc. in Sec. SE NW SW

Geol. \_\_\_\_\_  
 Contr. \_\_\_\_\_

Pool Fox-Bush

FIRST REPORT  
 APR 11 1956

Date Comm. 4-2-56  
surface set

APR 17 1956

*[Handwritten signature]*

R.G.

Co.

Lse.

No.

Sec.

T.

R.