


DX 78-1

Cowley

Section 28 Township 31 Range 7E
 Well No. #1 Brooks
 Company J. P. Gaty

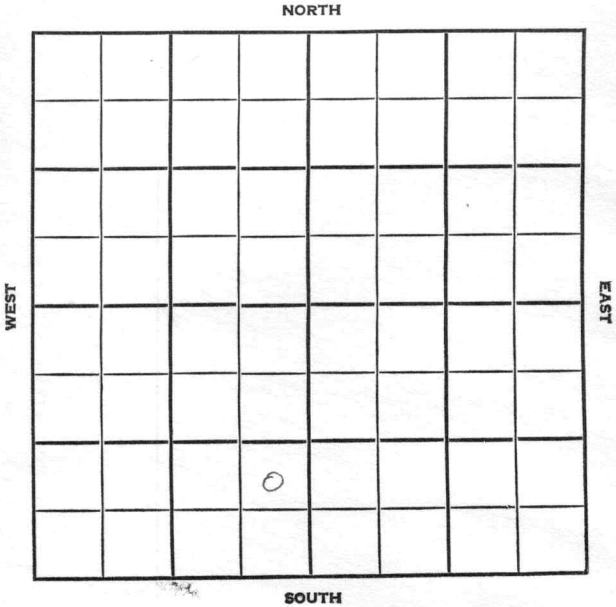

Cowley

KANSAS

SEC.

28

TWP.

31

R.

7E

WELL NO.

#1- Brooks

FARM

COMPANY

J.P. Gaty

CONTRACTOR

Morrison

WILDCAT


FT. FROM N. LINE

FT. FROM S. LINE

FT. FROM E. LINE

FT. FROM W. LINE

NE SE SW

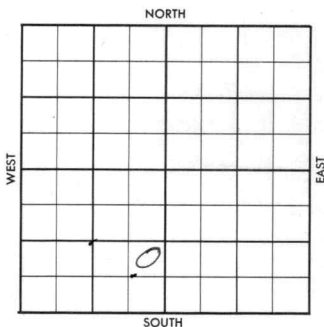

1956

ELEVATION

1316 KB

REPORT

8-8

MIR

8-15

Comm. 8-7-56

8 5/8" @ 150

D & A

BL. 1627'; Stall. 1678'; L. 1820';

KC. 2048'; Lay. 2088-2116

TD 2140'

ABANDONED

County Cowley Elev. _____
 Sec. 28 Twp. 31 Rge. 7E
 Company J. P. Gaty
 Farm Name Brooks No. 1

TOPS	DEPTH	LOG	DATUM	Loc. in Sec.
Anh.				NE SE SW
TP.				
H.				
Tr.				
Dg.				
BL.				
L.				Geol. _____
K.C.				Contr. _____
B.K.C.				Morrison
Ce.				Pool _____
C.				Wildcat
M.				
M.				
K.				
Mz.				
Mq.				
V.				
S.				
S.				
A.				
R.				
PE.				
G.				
T.D.				

FIRST REPORT

Date Comm.

AUG 8 '56

M I R

AUG 10 1956

R. G.

County Cowley Elev. 1316 K13
 Sec. 28 Twp. 31 Rge. 7E
 Company J. P. Gaty
 Farm Name Brooks No. 1

TOPS	DEPTH	LOG	DATUM	Loc. in Sec.
Anh.				
Tp. <u>BL</u>	<u>1627</u>			<u>NE SE SW</u>
H. <u>57211</u>	<u>1678</u>			
Tr.				
Dg.				
BL.				
L.	<u>1820</u>			
K.C.	<u>2048</u>			Geol. _____
Bkt. <u>LBY</u>	<u>2088-2116</u>			Contr. _____
Ce.				<u>Morrison</u>
C.				
M.				Pool _____
M.				<u>Wildcat</u>
K.				
Mz.				
Mq.				
V.				
S.				
S.				
A.				
R.				
Pe.				
G.				
TD.	<u>2140</u>			

ABANDONED

Date Comm.

AUG 15 '56

MIR AUG 15 '56 8-7-56 85/8 150

BL 1627

DEA