
Russell

Form 51—5M—5-34—Palace

Map No. KANSAS Sec. 22 Twp. 15 R. 15W

Well No. 1 Penn Mutual Farm

Wolfe Creek Unit Company

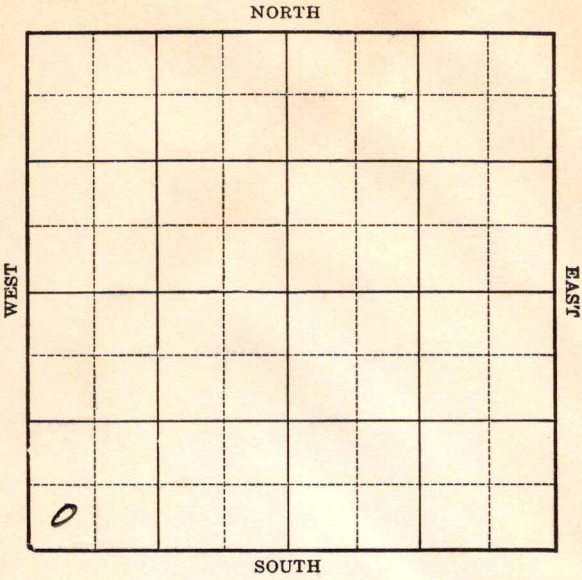

Location

Drilling Remarks

Rig Up

Drilling Remarks

RECORD

Cased in. ft.

Sand

Gas

Oil

Total Depth

PRODUCTION

1st 24 hrs. Nat.

1st 24 hrs. after shot

Gas cu. ft.

Dry Hole

Abandoned

Form 252-A
5M 7-34 MPC

Russell

Map No. KANSAS Sec. 22 Twp. 15 R. 15w

Well No. 1 Penn Mutual Farm


Wolfe Creek Stl Company

330 Ft. from N. Line

Ft. from S. Line

Ft. from E. Line

330 Ft. from W. Line

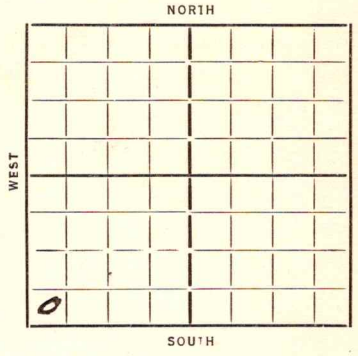

Date 1934	REPORT
12/19	Location
12/27	—
1/3/35	Cellar
1/10	—
1/17	— 1/24 — 1/31 — 2/7 —
2/14	— 2/21 — 2/28 —
3/7	Rog
3/14	—
3/21	Rgn
3/28	Spud
4/4	Dlg 760 15" 395
4/11	" 985 Anhy 973 12" 983
4/18	" 1165
4/26	" 1980
5/2	10" 2155 2325 WR 10"
5/9	Run 8" 2615
5/16	8" 2720 Co.
5/23	2880 WR 8"
5/29	—
6/6	6" 3150 KC 3185 Dlg 3280
6/13	5" 3460 Cong 3428 Lib 3475 TJ 3504 (OVER)

6/19 Silicone 3475
T-1 3509
J.O.A.

ABANDONED

Form 26-1M Rev 9-28 Russell KANSAS

Map No. 73 Sec. 22 Twp. 15 R. 15W


Well No. 1 – Penn Mutual

Wolfe Creek etal Company

Contractor

FIRST REPORTS

SECTION PLAT

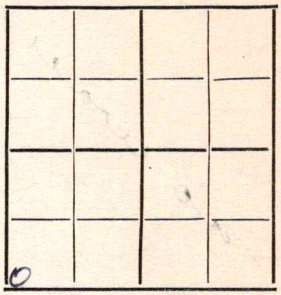

..... Ft. from N. Line

330 Ft. from S. Line

..... Ft. from E. Line

330 Ft. from W. Line

Location ✓

Rig up

Drilling and Remarks:

RECORD

Cased ..... in., ... ft.

Sand

Gas

Oil

Total Depth

PRODUCTION

1st 24 hrs. Nat.

1st 24 hrs. after shot

Gas ..... Cu. Ft.

Dry Hole

Abandoned

Date

12-19-34 192.....

ORVAL MANNSCHRECK Scout

Form 26—1M Bks. 9-28

Russell

KANSAS

Map No. 73 Sec. 22 Twp. 15 R. 15W


Well No. 1-Penn Mutual

Wolfe Creek etal Company

Contractor

ABANDONED

SECTION PLAT

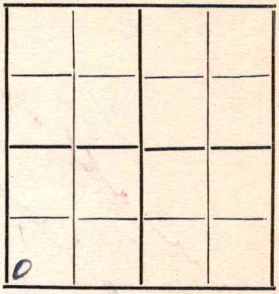

Ft. from N. Line

330 Ft. from S. Line

Ft. from E. Line

330 Ft. from W. Line

Location

Rig up

Drilling and Remarks:

W + F

RECORD

Cased in., ft.

Sand Lansing 3475

Gas

Oil

Total Depth 3509

PRODUCTION

1st 24 hrs. Nat.

1st 24 hrs. after shot

Gas Cu. Ft.

Dry Hole

Abandoned

Date

6-19-35 192

ORVAL MANNSCHRECK Scout