
KANSAS

FORM 51 25M 3-49 PETROL Russell

Section 23 Township 15 Range 15W

Well No. #1 J. E. Morgenstern

Company Texas Company

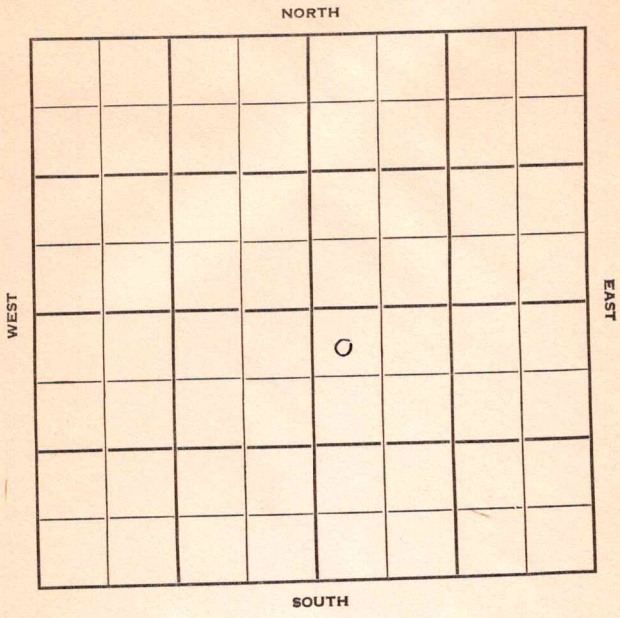

FORM 252-B
10M 11-50 PETROL

Russell KANSAS

Sec. 23 Twp. 15 R. 15W

Well No. #1 J. E. Morgenstern Farm

Texas Co. Company

B & R Drlg. - Contr. Contractor

Wildcat


330' Ft. from N. Line

Ft. from S. Line

Ft. from E. Line

330' Ft. from W. Line

NW NW SE

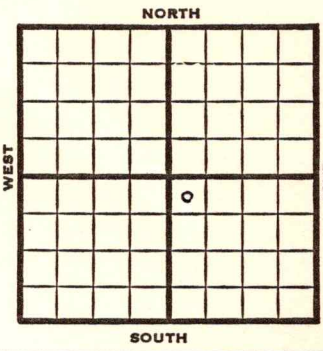

1951	Elev. 1889' REPORT
8/22	Spud 8-19-51 Drlg. 255'
9/12	Spud 8-19-51 D & A TD 3441' 10" @ 915' Top 2846' Heeb 3076' Tor. 3095' KC 3137' Cong. 3372' DST 3370-78 open 1 hr. rec 22' mud Arb. 3415' DST 3417-41 open 1 hr. rec 1500' water TD 3441' D & A ABANDONED

FORM 275 FOR SALE BY KANSAS BLUE PRINT CO.


County Russell State Kansas

Sec. 23 (Blk. Twp.) 15 (Sur. Rge.) 15W Map No.

Operator Texas Company

Well No. 1 Farm J. E. Morgenstern

Elev. Location NW NW SE

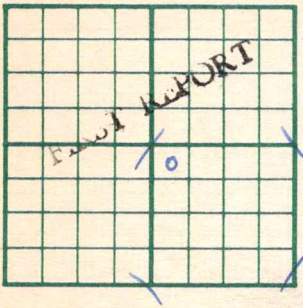

330 Ft. From N Line SE

330 Ft. From W Line Quarter

1st. Report AUG 22 1951

Completion

Remarks B & R Drlg. - Contr.

Spudding Date 8-19-51

Drlg. Data Wildcat

drlg. 255

J. E. TYRA

FORM 275 FOR SALE BY KANSAS BLUE PRINT CO.


County Russell State Kansas

Sec. 23 (Blk. Twp.) 15 (Sur. Rge.) 15W Map No.

Operator Texas Company

Well No. 1 Farm J. E. Morgenstern

Elev. 1889 Location NW NW SE

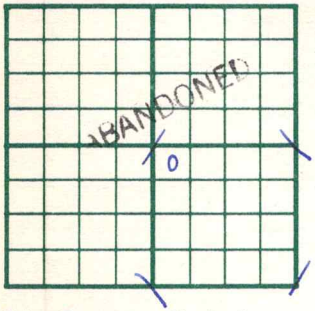

330 Ft. From N Line SE

330 Ft. From W Line Quarter

1st. Report

Completion SEP 1 2 1951

Remarks Wildcat

B & R Drlg. - Contr.

Spudding Date 8-19-51

Drlg. Data D & A TD 3441

10" @ 915 Top. 2846 Heeb. 3076

Tor. 3095 KC 3137 Cong. 3372 DST 3370-

78 open 1 hr. Rec. 22' mud Arb. 3415

DST 3417-41 open 1 hr. Rec. 1500' water

TD 3441 D & A

J. E. TYRA