

Russell

Section 24 Township 15 Range 15WWell No. #1 SchweinCompany Armer & Black etal.

NORTH

	0						

SOUTH

WEST

EAST

KANSAS

Russell

Sec. 24 Twp. 15 R. 15W

Well No. #1 Schwein Farm

Armer & Black et al. Company

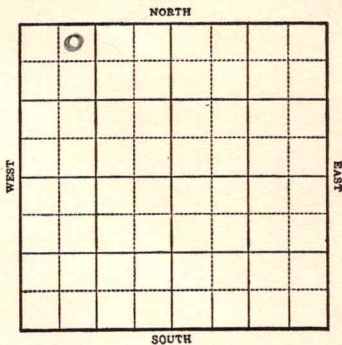
Wildcat

330 Ft. from N. Line

_____ Ft. from S. Line

_____ Ft. from E. Line

990 Ft. from W. Line



1944

R E P O R T

3/8

Drilling 2590'

3/15

Lans 3111

Arb. 3354

TD 3398

No Shows

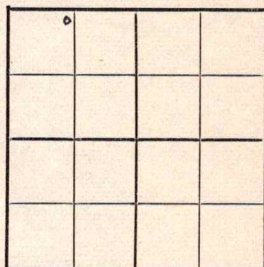
ABANDONED

KANSAS

Map No. 13 Sec. 24 Twp. 15 R. 15WWell No. 1 SchweinArmer & Black et al. CompanyFIRST REPORT Contractor

NE NW NW

SECTION PLAT

330 Ft. from N. Line Ft. from S. Line Ft. from E. Line990 Ft. from W. Line

Wildcat

Location Rig up

Drilling and Remarks:

2590

RECORD

Cased in., ft.Sand Gas Oil Total Depth

PRODUCTION

1st 24 hrs. Nat. 1st 24 hrs. after shot Gas Cu. Ft.Dry Hole Abandoned

Date

MAR 8 1944 19 S. J. LEWIS Scout

KANSAS

Map No. 73 Sec. 24 Twp. 15 R. 15WWell No. 1 SchweinArmer & Black et al.

Company

ABANDONED

Contractor

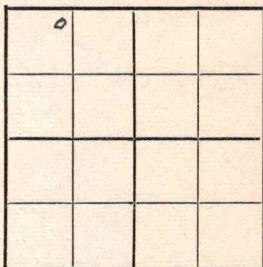
NE NW NW

SECTION PLAT

330 Ft. from N. Line

Ft. from S. Line

Ft. from E. Line

990 Ft. from W. Line

Wildcat

Location _____

Rig up _____

Drilling and Remarks:

*Line 3111**Cr 3354**No shows*

RECORD

Cased _____ in., _____ ft.

Sand _____

Gas _____

Oil _____

Total Depth 3378

PRODUCTION

1st 24 hrs. Nat. _____

1st 24 hrs. after shot _____

Gas _____ Cu. Ft.

Dry Hole _____

Abandoned _____

Date

MAR 15 1944 19S. J. LEWIS

Scout