

KANSAS


FORM 51 5M 1-42 PETROL

Russell

Section 25 Township 15 Range 15 W

Well No. 1 DeWald

Company Royer  
~~Duwo~~ & Farris etal

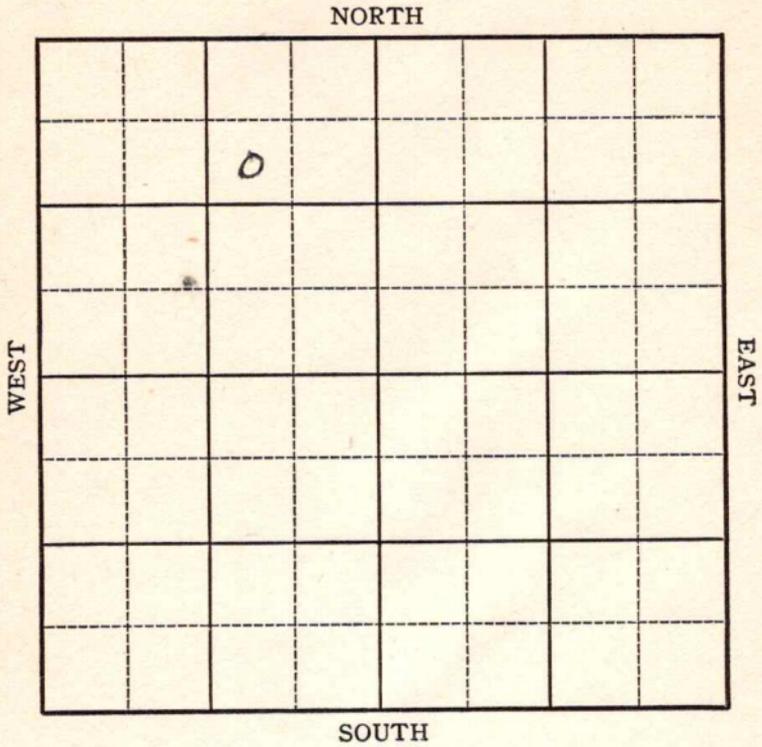


Sec. 25 Twp. 15 R. 15-W

Well No. #1 DeWald Farm

Royer Duwo & Farris etal Company

NORTH

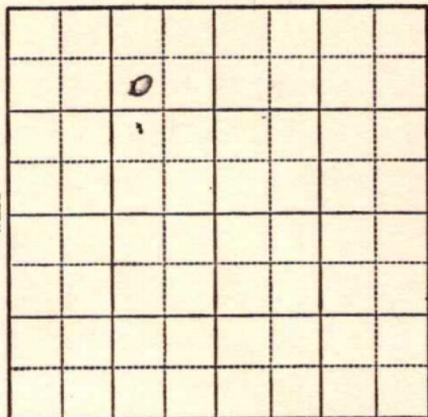

990 Ft. from N. Line

\_\_\_\_\_ Ft. from S. Line

990 Ft. from E. Line

\_\_\_\_\_ Ft. from W. Line

Elev. 1897

SOUTH

1943

R E P O R T

11/17 Rotary  
 11/24 "  
 12/ 1 "  
 12/8 "  
 12-15 Spud  
 12/22 8" @ 300  
           Anhy 910  
           Drlg. 1210  
 12/29 Drlg 1708'

1944  
1/5

**Arb 3396**  
 No shows  
 TD 3417'

**ABANDONED**

KANSAS

Map No. 72 Sec. 25 Twp. 15 R. 15W

Well No. 1 DeWald

Duwe & Farris et al. Company

FIRST REPORT Contractor

SW NE NW

SECTION PLAT

990 Ft. from N. Line

Ft. from S. Line

990 Ft. from E. Line

Ft. from W. Line


Wildcat

Location

Rig up

Drilling and Remarks:

Rotary

RECORD

Cased in., ft.

Sand

Gas

Oil

Total Depth

PRODUCTION

1st 24 hrs. Nat.

1st 24 hrs. after shot

Gas Cu. Ft.

Dry Hole

Abandoned

Date

NOV 17 1943

19

S. J. LEWIS

Scout

Map No. 73 Sec. 25 Twp. 15 R. 15W

Well No. 1 DeWald

Royer & Farris Company

CORRECTION Contractor

SW NE NW

SECTION PLAT

	o		

990 Ft. from N. Line

\_\_\_\_\_ Ft. from S. Line

990 Ft. from E. Line

\_\_\_\_\_ Ft. from W. Line

Wildcat

Location \_\_\_\_\_

Rig up \_\_\_\_\_

Drilling and Remarks:

Reported

Duwe & Farris

RECORD

Cased \_\_\_\_\_ in., \_\_\_\_\_ ft.

Sand \_\_\_\_\_

Gas \_\_\_\_\_

Oil \_\_\_\_\_

Total Depth \_\_\_\_\_

PRODUCTION

1st 24 hrs. Nat. \_\_\_\_\_

1st 24 hrs. after shot \_\_\_\_\_

Gas \_\_\_\_\_ Cu. Ft.

Dry Hole \_\_\_\_\_

Abandoned \_\_\_\_\_

Date

DEC 15 1943

19

S. J. LEWIS

Scout

KANSAS

Map No. 73 Sec. 25 Twp. 15 R. 15W

Well No. 1 Dewald

Royer & Farris etal. Company

ABANDONED Contractor

SW NE NW

SECTION PLAT

990 Ft. from N. Line

\_\_\_\_\_ Ft. from S. Line

990 Ft. from E. Line

\_\_\_\_\_ Ft. from W. Line

	o		

Wildcat

Location \_\_\_\_\_

Rig up \_\_\_\_\_

Drilling and Remarks:

*Cu 43396*

*No shows*

RECORD

Cased \_\_\_\_\_ in., \_\_\_\_\_ ft.

Sand \_\_\_\_\_

Gas \_\_\_\_\_

Oil \_\_\_\_\_

Total Depth 3417

PRODUCTION

1st 24 hrs. Nat. \_\_\_\_\_

1st 24 hrs. after shot \_\_\_\_\_

Gas \_\_\_\_\_ Cu. Ft.

Dry Hole \_\_\_\_\_

Abandoned \_\_\_\_\_

Date

JAN 5 1944 19

S. J. LEWIS

Scout