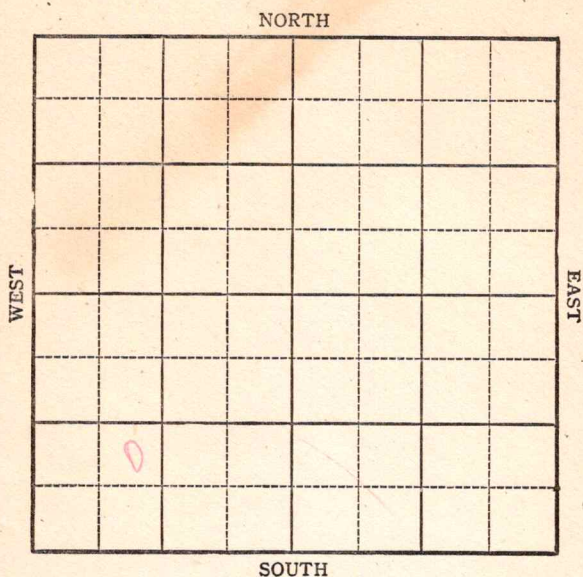


KANSASSection 31 Township 15 Range 15WWell No. #1 DewaldCompany Kiowa Drlg.

KANSAS

Russell

Sec. 31 Twp. 15 R. 15W

Well No. #1 Dewald Farm

Kiowa Drlg.

Company

Wildcat

Ft. from N. Line


990

Ft. from S. Line

Ft. from E. Line

990

Ft. from W. Line

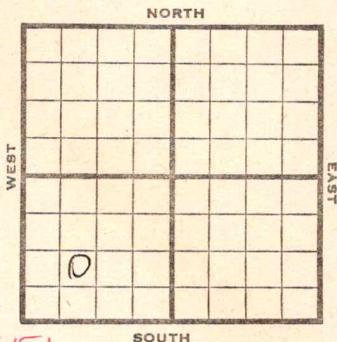

NE SW SW *Elev. 1851*

1944

R E P O R T

12/20 Location

12/29 Drlg. 100'

1945

1/3

Anhy 954

8" @ 959 WOC

1/10 Drlg 2910

1/17

Lans 3146

Drlg 3361

1/24

Cong. 3380

Arb. 3460


TD 3476

ABANDONED

Pool Name WildcatMap No. 73 Sec. 31 Twp. 15 R. 15WWell No. 1 DewaldKiowa Drlg. CompanyFIRST REPORT Contractor

NE SW SW

SECTION PLAT

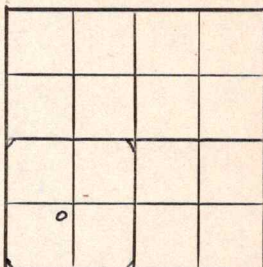 Ft. from N. Line990 Ft. from S. Line Ft. from E. Line990 Ft. from W. Line

Russell

Location XRig up

Drilling and Remarks:

RECORD

Cased in., ft.Sand Gas Oil Total Depth

PRODUCTION

1st 24 hrs. Nat. 1st 24 hrs. after shot Gas Cu. Ft.Dry Hole Abandoned

Date

DEC 20 1944

19

S. J. LEWIS

Scout

Pool Name WildcatMap No. 73 Sec. 31 Twp. 15 R. 15WWell No. 1 DewaldKiowa Drlg. CompanyABANDONED Contractor

NE SW SW

SECTION PLAT

 Ft. from N. Line990 Ft. from S. Line Ft. from E. Line990 Ft. from W. LineRussellLocation Rig up

Drilling and Remarks:

Conc 380
Cr 3460

RECORD

Cased in., ft.Sand Gas Oil Total Depth 3426

PRODUCTION

1st 24 hrs. Nat. 1st 24 hrs. after shot Gas Cu. Ft.Dry Hole Abandoned

Date

JAN 24 1945

19

S. J. LEWIS

Scout