

KANSAS


Russell

Section 26 Township 15 Range 15W

Well No. 1 Anschutz

Company Alkay Oil

Boxberger Pool
NORTH

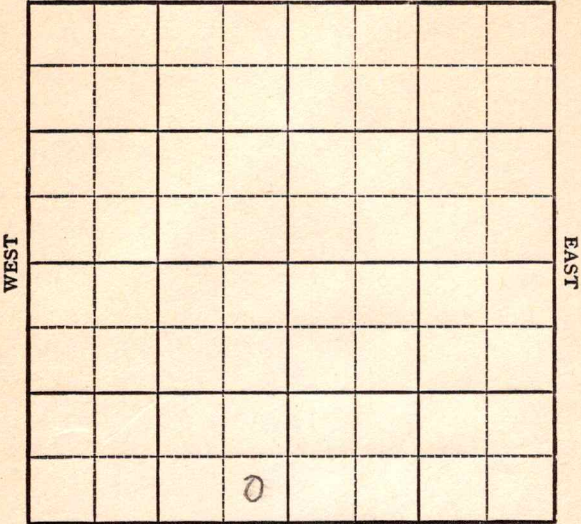

SOUTH

Russell

KANSAS

Sec. 26 Twp. 15 R. 15-W

Well No. #1 Anschutz Farm

Alkay Oil

Boxberger

Company


 Ft. from N. Line

330 Ft. from S. Line

m330 Ft. from E. Line

 Ft. from W. Line

SE SW

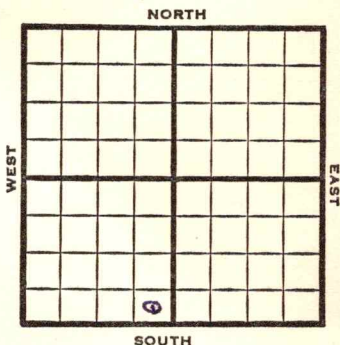

1948

Elev -

R E P O R T

9/29

8" @ 206'

Drlg 2400'

10/6

Drlg 3279'

10/13

Lans. 3172'

Arb 3424'

TD 3425'

ABANDONED

Map No. _____ Sec. 26 Twp. 15 R. 15W


Well No. 1 Anschutz

Alkay Oil Company

FIRST REPORT Contractor

SE SW

SECTION PLAT

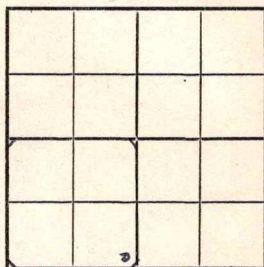

_____ Ft. from N. Line

330 Ft. from S. Line

330 Ft. from E. Line

_____ Ft. from W. Line

Russell County

Location _____

Rig up _____

Drilling and Remarks:

8" @ 206

drlg. 2400

RECORD

Cased _____ in., _____ ft.

Sand _____

Gas _____

Oil _____

Total Depth _____

PRODUCTION

1st 24 hrs. Nat. _____

1st 24 hrs. after shot _____

Gas _____ Cu. Ft.

Dry Hole _____

Abandoned _____

Date

SEP 29 1948

19

S. J. LEWIS

Scout

Map No. 73 Sec. 26 Twp. 15 R. 15W


Well No. 1 Anschutz

Alkay Oil Company

ABANDONED Contractor

SE SW

SECTION PLAT

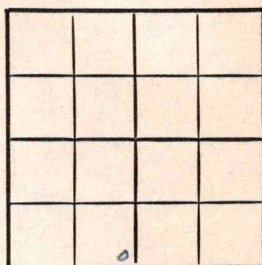

 Ft. from N. Line

330 Ft. from S. Line

330 Ft. from E. Line

 Ft. from W. Line

Russell County

RECORD

Location

Rig up

Drilling and Remarks:

Lane 3172

Ar 83424

Cased in., ft.

Sand

Gas

Oil

Total Depth 3425

PRODUCTION

1st 24 hrs. Nat.

1st 24 hrs. after shot

Gas Cu. Ft.

Dry Hole

Abandoned

Date

OCT 13 1948 19

S. J. LEWIS Scout