

Cowley KANSAS

SEC. 30	TWP. 31	R. 7E
-------------------	-------------------	-----------------


WELL NO. _____
I. Fabara FARM

COMPANY _____
Ashton Oil

CONTRACTOR _____

Mansur Pool

~~990~~ **330** _____ Ft. from N. Line
 _____ Ft. from S. Line
 _____ Ft. from E. Line
330 _____ Ft. from W. Line

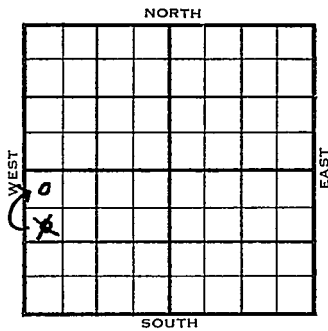

NW
~~SW~~ NW SW

	ELEVATION	REPORT
1954	1345'	

11/17

Location

1955
2/16

Gas well TD 2155 8" @ 100
 Layton 2117 TD 2155 4" @ 2155
 CO to 2140 24/2117-24 frac.
 F/1½ BOPH Lans 1840 Layton 2086
 Layton sd. 2107 KC 2136
 Comp. F/2,250,000 CFGPD ½ BOPH

COMPLETED

County Cowley State Kansas

Sec. 30 (Blk. 31) (Sur. Rge.) 7E Map No.

Operator Ashton Oil

Well No. 1 Farm Jabara

Elev. 1345 Location NW NW SW

330 Ft. From N Line SW

330 Ft. From W Line Quarter

1st. Report

Completion FEB 16 1955

Remarks Mansur Pool

Spudding Date

Drlg. Data Gas well TD 2155

8" @ 100 Layton 2117 TD 2155

4" @ 2155 CO to 2140 24/ 2117-24

frac F/ 1 1/2 boph Lans. 1840 Layton 2086

Layton sd. 2107 KC 2136

Comp. F/ 2,250,000 cfgpd 1/2 boph