


Cowley

KANSAS

SECTION 31 TOWNSHIP 31 RANGE 7E

WELL NO. #1 Jabara "A"

COMPANY Jimmy Razook

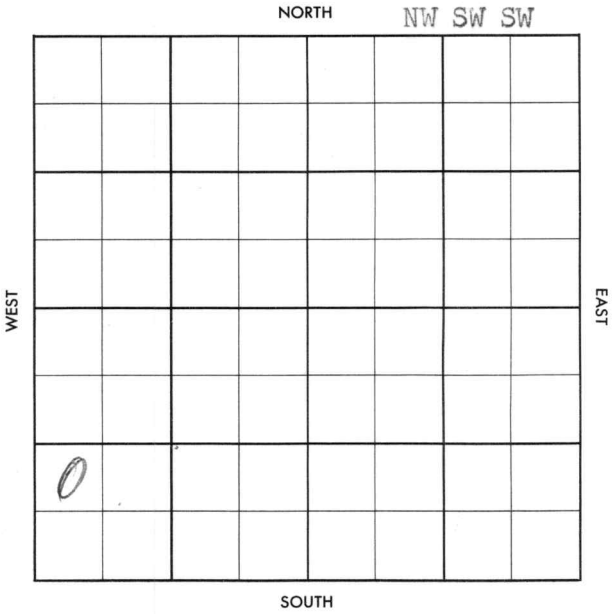

County Cowley Elev. _____
 Sec. 31 Twp. 31 Rge. 7E
 Company Jimmy Razook
 Farm Name Jabara "A" No. 1

TOPS	DEPTH	LOG	DATUM	Loc. in Sec.
Anh.				NW SW SW
TP.				
H.				
Tr.				
Dg.				
BL.				
L.				Geol. _____
K.C.				Contr _____
B.K.C.				<u>Hallmark</u>
Ce.				Pool _____
C.				<u>Estes</u>
M.				
M.				
K.				
Mz.				
Me.				
V.				
S.				
S.				
A				
R.				
PE.				
G.				
T.D.				

FIRST REPORT
 JUN 19 57

Date Comm. 6-13-57 Texas - FO
8" @ 150/100 drlg. 1205

Handwritten signature/initials

Co.
Lse.
No.
Sec.
T.
R.

County Coxley Elev. 1404
 Sec. 31 Twp. 31 Rge. 7E
 Company Jimmy Razook
 Farm Name Jabara "A" No. 1

Co.
Lse.
No.
Sec.
T.
R.

TOPS	DEPTH	LOG	DATUM
Anh.			
Tp. <u>stain</u>	<u>1724</u>		
H. <u>" sd</u>	<u>1756</u>		
Tr.			
Dg.			
Bl.			
L.			
K.C. <u>GROUP</u>	<u>2134</u>		
B.K.C.			
Ce. <u>coll. gr</u>	<u>2195</u>		
C.			
M.			
M.			
K.			
Mz.			
Mo.			
V.			
S.			
S.			
A.			
R.			
PE.			
G.			
T.D.	<u>2252</u>		

Loc. in Sec. NW SW SW
 Geol. _____
 Contr. _____
Hallmark
 Pool _____
Estes
COMPLETE
AUG 14 57

Date Comm. 6-13-57 Texas - FO
8" @ 150/100 drlg. 1205 JUN 20 57 5 1/2
2251 MICT JUL 3 57 CO JUL 10 57
JUL 17 57 MICT 20/2201-06
\$ 1 B0 + 4 BW FRAC 5 X 5
\$ 8 B0 + 38 BW JUL 24 57 ✓ JUL 31 57
POP? AUG 8 57 X wtr decreased to
0 P. est. 40 Bopd no/wtr AUG 14
X comp. 25 Bopd no/wtr
TEXAS