


Section 28 Township 15 Range 15W

Well No. #1 Dunler

Company B & R Drlg.

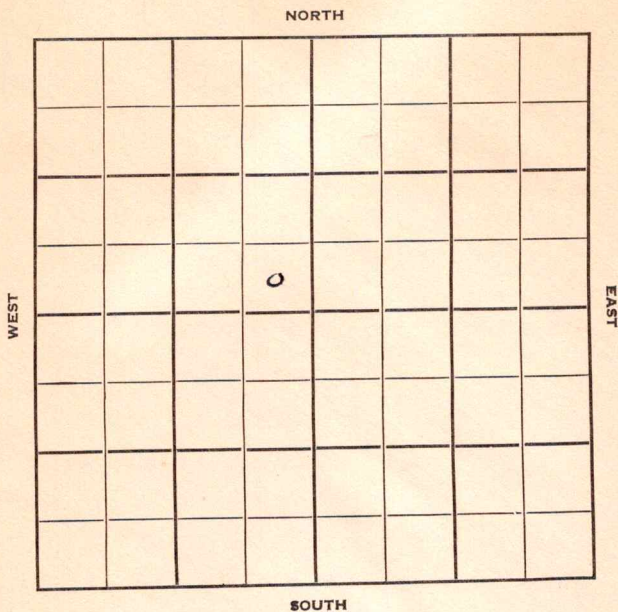

Russell

KANSAS

Sec. 28 Twp. 15 R. 15W

Well No. #1 Dumler Farm

B & R Drlg. Company


Wildcat Contractor

\_\_\_\_\_ Ft. from N. Line

330' Ft. from S. Line

330' Ft. from E. Line

\_\_\_\_\_ Ft. from W. Line

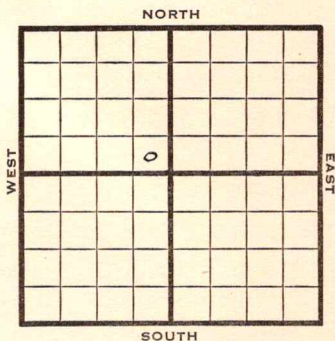

SE SE NW

1950

Elev. 1880'

REPORT

3/22

Location

4/5

TD 3470'

8"@ 200

Lans 3137'

Cong 3370'

Arb 3466'

D&A

Aband.

**ABANDONED**

Map No. \_\_\_\_\_ Sec. 28 Twp. 15 R. 15W

Well No. 1 Dumler

B & R Drlg. Company

Contractor

SE SE NW

E1. 1880  
SECTION PLAT

\_\_\_\_\_ Ft. from N. Line

330 Ft. from S. Line

330 Ft. from E. Line

\_\_\_\_\_ Ft. from W. Line


FIRST REPORT

Russell County

Location X

Rig up \_\_\_\_\_

Drilling and Remarks:

RECORD

Cased \_\_\_\_\_ in., \_\_\_\_\_ ft.

Sand \_\_\_\_\_

Gas \_\_\_\_\_

Oil \_\_\_\_\_

Total Depth \_\_\_\_\_

PRODUCTION

1st 24 hrs. Nat. \_\_\_\_\_

1st 24 hrs. after shot \_\_\_\_\_

Gas \_\_\_\_\_ Cu. Ft.

Dry Hole \_\_\_\_\_

Abandoned \_\_\_\_\_

Date

MAR 22 1950 19

J. E. TYRA Scout

Kansas

Map No. \_\_\_\_\_ Sec. 28 Twp. 15 R. 15W

Well No. 1 Dumler

B & R Drlg. Company

Contractor

SE SE NW

*E. 1880*  
SECTION PLAT

\_\_\_\_\_ Ft. from N. Line

330

\_\_\_\_\_ Ft. from S. Line

330

\_\_\_\_\_ Ft. from E. Line

\_\_\_\_\_ Ft. from W. Line

ABANDONED			

Russell County

Location \_\_\_\_\_

Rig up \_\_\_\_\_

Drilling and Remarks:

*8" @ 200  
Land 3137  
Cang 3370  
arb 3466  
D & A*

RECORD

Cased \_\_\_\_\_ in., \_\_\_\_\_ ft.

Sand \_\_\_\_\_

Gas \_\_\_\_\_

Oil \_\_\_\_\_

Total Depth 3470

PRODUCTION

1st 24 hrs. Nat. \_\_\_\_\_

1st 24 hrs. after shot \_\_\_\_\_

Gas \_\_\_\_\_ Cu. Ft.

Dry Hole \_\_\_\_\_

Abandoned \_\_\_\_\_

Date

ADD 5 1950

19

J. E. TYRA

Scout